

Notice: Fill out COMPLETELY and return to Conservation Division at the address below within 60 days from plugging date.

KANSAS CORPORATION COMMISSION
OIL & GAS CONSERVATION DIVISION
WELL PLUGGING RECORD
K.A.R. 82-3-117

Form CP-4
December 2003
Type or Print on this Form
Form must be Signed
All blanks must be Filled

Lease Operator: Prospect Oil & Gas Corp.
Address: PO Box 837, Russell, KS 67665
Phone: (785) 483-0492 Operator License #: 6627
Type of Well: D & A Docket #: _____
(Oil, Gas D&A, SWD, ENHR, Water Supply Well, Cathodic, Other) (if SWD or ENHR)
The plugging proposal was approved on: 9-20-09 (Date)
by: Pat Bedore (KCC District Agent's Name)
Is ACO-1 filed? Yes No If not, is well log attached? Yes No
Producing Formation(s): List All (If needed attach another sheet)

Depth to Top: _____ Bottom: _____ T.D. _____

Depth to Top: _____ Bottom: _____ T.D. _____

Depth to Top: _____ Bottom: _____ T.D. _____

API Number: 15-065-23,564-0000
Lease Name: Pawley "A"
Well Number: 1
Spot Location (QQQQ): _____ SW - NE - NE
910 Feet from North / South Section Line
1,180 Feet from East / West Section Line
Sec. 25 Twp. 9 S. R. 22 East West
County: Graham
Date Well Completed: 9-20-09
Plugging Commenced: 9-20-09
Plugging Completed: 9-20-09

Show depth and thickness of all water, oil and gas formations.

Oil, Gas or Water Records		Casing Record (Surface Conductor & Production)				
Formation	Content	From	To	Size	Put In	Pulled Out
				8 5/8"	219'	Cmt'd. w/150 sax

Describe in detail the manner in which the well is plugged, indicating where the mud fluid was placed and the method or methods used in introducing it into the hole. If cement or other plugs were used, state the character of same depth placed from (bottom), to (top) for each plug set.
Run drill pipe to 3,875', pump 25 sax cement thru drill pipe; run drill pipe to 1,900' pump 25 sax cement thru drill pipe; run drill pipe to 1,120', pump 100 sax cement thru drill pipe; run drill pipe to 270', pump 40 sax cement thru drill pipe; push wiper plug to 40', dump 10 sax cement on plug to cellar. Circulate 30 sax cement down rat hole and 15 sax cement down mouse hole.

Name of Plugging Contractor: Shields Drilling Co. License #: 5184
Address: PO Box 709, Russell, KS 67665

RECEIVED
OCT 05 2009

Name of Party Responsible for Plugging Fees: Prospect Oil & Gas Corporation
State of KANSAS County, RUSSELL, ss.

KCC WICHITA


Burton Beery, Drilling Supt. Contractor
(Employee of Operator or Operator) on above-described well, being first duly sworn on oath, says: That I have knowledge of the facts statements, and matters herein contained, and the log of the above-described well is as filed, and the same are true and correct, so help me God.

(Signature) Burton Beery
(Address) PO Box 709, Russell, KS 67665

SUBSCRIBED and SWORN TO before me this 2nd day of October, 2009

Ruth Phillips
Notary Public

My Commission Expires:

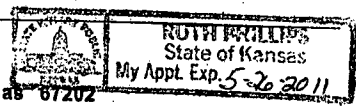

Mail to: KCC - Conservation Division, 130 S. Market - Room 2078, Wichita, Kansas 67202




Shields

Russell, Kansas

WELL LOG

Operator: Prospect Oil & Gas Corp.
 Well: Pawley "A" #1
 Commenced: 9-11-09
 Completed: 9-20-09
 Contractor: Shields Drilling Co.

Well Description: 910' FNL, 1,180' FEL
 NE/4 Sec. 25-9S-22W
 Graham Co., KS

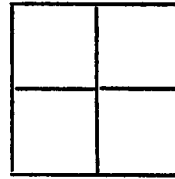

CASING RECORD		
Size	Run	Pulled
8 5/8"	219'	Cmtd. w/150 sax

Elevation: 2,373' K.B.

Treatment:

Production:

Tops:

..... Figures Indicate Bottom of Formations

Sand & shale	1,330'	
Sand	1,530'	
Sand & redbed	1,875'	
Anhydrite	1,911'	
Redbed & shale	2,580'	
Shale	3,350'	
Shale & lime	3,710'	
Lime	3,911'	
Arbuckle	3,985'	RTD

RECEIVED
 OCT 05 2009
 KCC WICHITA

Notes