

15-163-00605-0000

STATE OF KANSAS
STATE CORPORATION COMMISSION

WELL PLUGGING RECORD

Give All Information Completely
Make Required Affidavit
Mail or Deliver Report to:
Conservation Division
State Corporation Commission
800 Bitting Building
Wichita, Kansas

Books _____ County, Sec. 22 Twp. 10S Rge. _____ (E) 20 (W)

Location as "NE/CNW/SW" or footage from lines S11-511-511

Lease Owner Champlin Refining Company

Lease Name J. J. Sutor Well No. 4

Office Address P.O. Dr. #552 Enid, Oklahoma

Character of Well (completed as Oil, Gas or Dry Hole) Dry Hole

Date well completed October 9 19 52

Application for plugging filed October 9 19 52

Application for plugging approved October 9 (Verbal) 19 52


Plugging commenced October 9 19 52

Plugging completed October 9 19 52

Reason for abandonment of well or producing formation _____

If a producing well is abandoned, date of last production _____ 19 _____

Was permission obtained from the Conservation Division or its agents before plugging was commenced? Yes

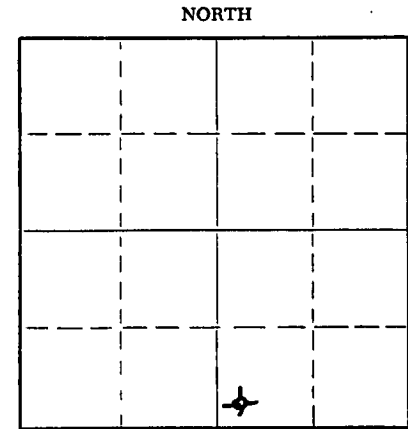

Locate well correctly on above Section Plat

Name of Conservation Agent who supervised plugging of this well Eldon Fetty, Hays, Kansas

Producing formation _____ Depth to top _____ Bottom _____ Total Depth of Well 3840 Feet

Show depth and thickness of all water, oil and gas formations.

OIL, GAS OR WATER RECORDS

CASING RECORD

FORMATION	CONTENT	FROM	TO	SIZE	PUT IN	PULLED OUT
				8 5/8"OD	163'	None

Describe in detail the manner in which the well was plugged, indicating where the mud fluid was placed and the method or methods used in introducing it into the hole. If cement or other plugs were used, state the character of same and depth placed, from _____ feet to _____ feet for each plug set.

Filled hole with heavy rotary mud from 3840' T.D. to 160' and set Halliburton plug at 160', 1/2 sack of hulls and 15 sacks of cement then filled hole with heavy rotary mud from top of cement to 40' set Halliburton plug, 1/2 sack of hulls and 10 sacks of cement filling hole to bottom of celler.

RECEIVED
STATE CORPORATION COMMISSION
OCT 10 1952

CONSERVATION DIVISION
Wichita, Kansas
(If additional description is necessary, use BACK of this sheet)

Name of Plugging Contractor Champlin Refining Company

Address P.O. Dr. #552 Enid, Oklahoma

STATE OF Kansas, COUNTY OF Barton, ss. S. P. Wall (employee of owner) or (owner or operator) of the above-described

well, being first duly sworn on oath, says: That I have knowledge of the facts, statements, and matters herein contained and the log of the above-described well as filed and that the same are true and correct. So help me God.

(Signature) S. P. Wall

P.O. Box 167 Ellinwood, Kansas
(Address)

SUBSCRIBED AND SWORN TO before me this 13th day of October, 19 52

My commission expires September 10, 1955


N. Kenneth Stevie
Notary Public.

24-2675-6 2-52-20M

PLUGGING
FILE SEC 22 T 10 R 2024
BOOK PAGE 52 LINE 1

15-163-00605-0000

(For use in Kansas only for reporting formation record)

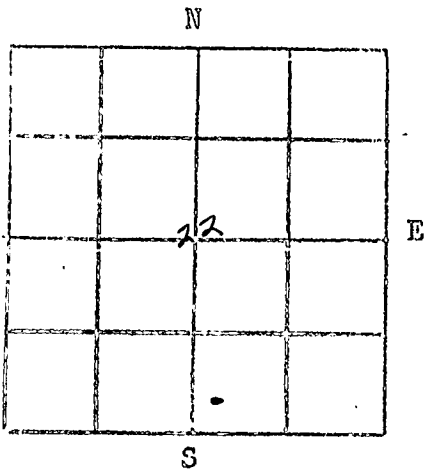

COUNTY Rooks SEC. 22 TWP. 10S RGE. 20W
 COMPANY OPERATING Champlin Refining Company
 OFFICE ADDRESS Box 552 - Enid, Oklahoma
 FARM NAME J. J. Sutor WELL NO. 4
 WELL LOCATED SW/4 SW/4 SE/4 Section 22-10S-20W
2310' from East Line & 330' from South Line SE/4
 CHARACTER OF WELL Dry Hole

DRILLING COMMENCED September 28, 1952 DRILLING COMPLETED October 9, 1952

SIZE	WEIGHT	THDS	MAKE	FT.	INS.	AMOUNT PULLED	CEMENT
8-5/8"	28#	8 Rd	National	153.32	-	-	100 Sacks

FORMATION RECORD

	<u>TOPS</u>	<u>BOTTOM</u>	<u>TOPS</u>	<u>BOTTOM</u>
Sand	0	70	Elevation: 2160'	D.F.
Sand-Shale	70	164		
Shale-Shells-Sand	164	750		
Shale-Sand-Shells	750	1367		
Shale-Redbed	1367	1625		
Anhydrite	1625	1665		
Shale-Shells	1665	1965		
Shells-Shale	1965	2156		
Shale-Lime	2156	2430		
Lime-Shale	2430	2527		
Lime-Shale	2527	3650		
Shale-Lime-Conglomerate	3650	3700		
Conglomerate	3700	3790		
Conglomerate-Arbuckle	3790	3840 T.D.		

RECORDED
 STATE COMMISSION
 OCT 16 1952
 CONSERVATION DIVISION
 Wichita, Kansas
Herbert A. ...
 Superintendent

PLUGGING
 FILE SEC 22 TWP 10 R 20W
 BOOK PAGE 52 LINE 1

Subscribed and sworn to before me
 this 16 day of October, 1952
Don Nise
 Notary Public

My Commission Expires August 14, 1954