


WELL PLUGGING RECORD

Give All Information Completely
Make Required Affidavit
Mail or Deliver Report to:
Conservation Division
State Corporation Commission
800 Bitting Building
Wichita, Kansas

Rooks County. Sec. 22 Twp. 10s Rge. (E) 20 (W)
Location as "NE/CNW $\frac{1}{4}$ SW $\frac{1}{4}$ " or footage from lines SE $\frac{1}{4}$ -SW $\frac{1}{4}$ -NW $\frac{1}{4}$
Lease Owner Champlin Refining Company
Lease Name Sayles Well No. 4
Office Address P. O. Drawer #552, Enid, Oklahoma.
Character of Well (completed as Oil, Gas or Dry Hole) Dry hole
Date well completed May 2, 1949
Application for plugging filed May 1, 1949
Application for plugging approved May 1, 1949
Plugging commenced May 3, 1949
Plugging completed May 3, 1949
Reason for abandonment of well or producing formation.....

NORTH

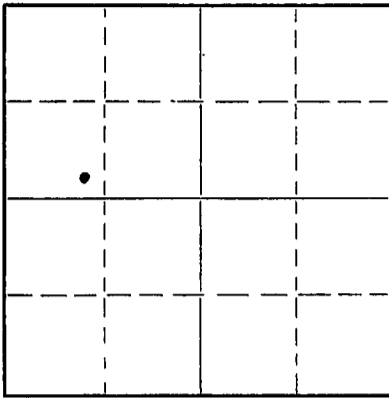

Locate well correctly on above
Section Plat

If a producing well is abandoned, date of last production..... 19.....
Was permission obtained from the Conservation Division or its agents before plugging was commenced? Yes

Name of Conservation Agent who supervised plugging of this well Mr. Eldon Petty,
Producing formation..... Depth to top..... Bottom..... Total Depth of Well 3850' Feet
Show depth and thickness of all water, oil and gas formations.

OIL, GAS OR WATER RECORDS

CASING RECORD

Formation	Content	From	To	Size	Put In	Pulled Out
				8 5/8"	166'	None

Describe in detail the manner in which the well was plugged, indicating where the mud fluid was placed and the method or methods used in introducing it into the hole. If cement or other plugs were used, state the character of same and depth placed, from.....feet to.....feet for each plug set.


filled hole with heavy rotary mud from 3850' TD to 166' (Bottom of surface casing) and set cement plug using 15 sacks of cement then filled hole with heavy rotary mud from top of plug to 30' and set cement plug from 30' to bottom of celler using 10 sacks of cement.
Used Halliburton Cementing company for setting plugs.

5-7-49

(If additional description is necessary, use BACK of this sheet)
Correspondence regarding this well should be addressed to Champlin Refining Company
Address P. O. Drawer #552, Enid, Oklahoma.

STATE OF Kansas. COUNTY OF Barton, ss.
S. P. Hall (employee of owner) or owner of the above-described well,
being first duly sworn on oath, says: That I have knowledge of the facts, statements, and matters herein contained and the log of the above-described well as filed and that the same are true and correct. So help me God.
(Signature) S. P. Hall
P. O. Box 167, Ellinwood, Kansas.
(Address)

SUBSCRIBED AND SWORN to before me this 6 th. day of May, 1949
October 24, 1951
My commission expires.....
W. Kenneth Steven Notary Public.

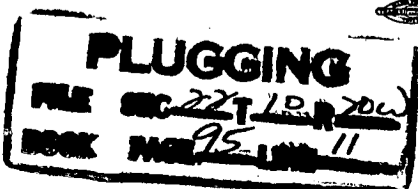

CHAMPLIN REFINING COMPANY

Sec. 22 Twp. 10 Rge. 20
County: Rocks, Kansas

SAYLES #4

Total Depth: 3850'
Comm: 4/19/49 Comp: 5/3/49

Casing

Cement

8 5/8" Set @ 166'

125 Sacks

Formation:	Depth:
Sand Lime & Shale	155
Shale & Shells	166
Shale	220
Shale & Shells	285
Shale Blue	425
Shale Gray	618
Sand light	643
Shale Gray	652
Shale Red	657
Shale & Shells	1100
Sand	1320
Shale & Shells	1340
Red Bed and Shale	1440
Anhydrite	1625
Shale	1965
Shale & Shells	2165
Lime & Shale	2750
Lime	2800
Lime & Sand	2815
Lime & Shale	3295
Lime	3580
Lime & Shale	3665
Lime	3873
Shale	3700
Lime & Shale	3730
Cherty Lime & Shale	3800
Cherty Lime	3820
Shale	3821
Artuckle Lime	3850

STATE OF KANSAS)
RUSSELL COUNTY) SS

I hereby certify that the above information is true and correct to the best of my knowledge.

Mary Lois Parkhurst

Subscribed and sworn to before me this 11th day of May, 1949.

Clara Hummel
Notary Public

My Commission Expires 6/17/50

