


Give All Information Completely
Make Required Affidavit
Mail or Deliver Report to:
Conservation Division
State Corporation Commission
211 No. Broadway
Wichita, Kansas

WELL PLUGGING RECORD

Ellis County, Sec. 6 Twp. 12S Rge. (E) 20 (W)

Location as "NE/CNW/SW" or footage from lines NW NW SW
Lease Owner Petroleum Operating Company
Lease Name Kroeger Well No. 1
Office Address P. O. Box 7027, Tulsa, Oklahoma
Character of Well (completed as Oil, Gas or Dry Hole) Dry Hole
Date well completed 2-13-1963
Application for plugging filed 2-13-1963
Application for plugging approved 2-13-1963
Plugging commenced 2-13-1963
Plugging completed 2-13-1963
Reason for abandonment of well or producing formation Dry Hole

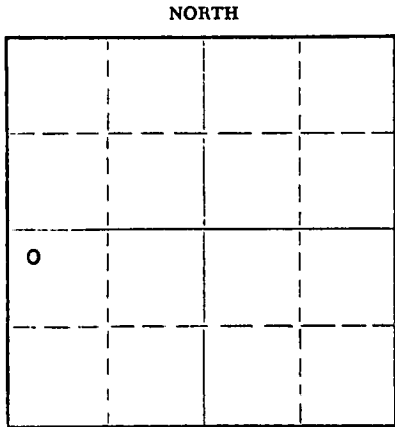

Locate well correctly on above
Section Plat

If a producing well is abandoned, date of last production 19
Was permission obtained from the Conservation Division or its agents before plugging was commenced? Yes

Name of Conservation Agent who supervised plugging of this well Eldon Petty
Producing formation Dry Hole Depth to top Bottom Total Depth of Well 3971 Feet
Show depth and thickness of all water, oil and gas formations.

OIL, GAS OR WATER RECORDS

CASING RECORD

FORMATION	CONTENT	FROM	TO	SIZE	PUT IN	PULLED OUT
Lansing	water	3589	3835	8-5/8"	166'	none
Conglomerate	--	3916	3971	T.D.		

Describe in detail the manner in which the well was plugged, indicating where the mud fluid was placed and the method or methods used in introducing it into the hole. If cement or other plugs were used, state the character of same and depth placed, from feet to feet for each plug set.

Bottom plug @ 500' w/20 sax cement
Middle plug @ 165' w/20 sax cement
Top plug @ 40' w/10 sax cement

STATE CORPORATION COMMISSION
2-21-1963
FEB 21 1963
CONSERVATION DIVISION
Wichita, Kansas

(If additional description is necessary, use BACK of this sheet)
Name of Plugging Contractor Rotary well drilled - no pipe set.
Address

STATE OF OKLAHOMA, COUNTY OF TULSA, ss.
Joseph Teichman (employee of owner) or (owner or operator) of the above-described well, being first duly sworn on oath, says: That I have knowledge of the facts, statements, and matters herein contained and the log of the above-described well as filed and that the same are true and correct. So help me God.

(Signature) [Signature]
P. O. Box 7027, Tulsa, Oklahoma (Address)

SUBSCRIBED AND SWORN TO before me this 19th day of February, 1963

My commission expires 3-17-64 Notary Public.



SHOLOM DRILLING COMPANY, INC.
P.O. BOX 7027
TULSA, OKLAHOMA

COMPANY: Petroleum Operating Company
FARM: Kroeger #1
LOCATION: NW NW SW Sec. 6 T12S R20W - Ellis County, Kansas
ROTARY DRILLING CONTRACTOR: Sholom Drilling Company, Inc.

COMMENCED: 2-3-63
COMPLETED: 2-13-63
I.P. : D & A

Elevation: 2262' K.B.
Rotary TD: 3971'

Casing Record:
8-5/8" @ 166' w/120 sax

L O G

0 - 166	Sand & Clay	DST #1 3760-3830
166 - 300	Shale & Shells	Rec. 65' muddy water
300 - 1025	Shale, Shells w/Sand streaks	
1025 - 1200	Shale & Sand	
1200 - 1400	Sand	Anhydrite 1676 (driller)
1400 - 1500	Red Bed	Topeka 3329
1500 - 1675	Red Bed & Shale	Heebner 3551
1675 - 1722	Anhydrite	Toronto 3574
1722 - 2062	Sandy shale, Lime streaks	Lansing 3589
		Base K.C. 3835
2062 - 2200	Shale & Shells	Marmaton 3857
2200 - 2325	Lime & Shale	Conglomerate 3916
2325 - 2425	Sandy Lime	
2425 - 2455	Sandy Shale	
2455 - 2515	Sand w/ Lime Streaks	
2515 - 2550	Shale & Lime	
2550 - 2580	Lime & Shale	
2580 - 2670	Sandy Lime & Shale	
2670 - 2720	Lime & Shale	
2720 - 2800	Sandy Shale	
2800 - 3060	Lime & Shale	
3060 - 3150	Shale	
3150 - 3250	Lime & Shale	
3250 - 3300	Shale & Lime	
3300 - 3360	Sand & Shale w/Lime Streaks	
3360 - 3435	Lime & Shale	
3435 - 3917	Lime	
3917 - 3953	Lime & Conglomerate	
3953 - 3971	Conglomerate	

FILED
STATE CORPORATION COMMISSION
2-21-1963
FEB 21 1963

CONSERVATION DIVISION
WINTER, KANSAS

STATE OF OKLAHOMA)
) ss.
COUNTY OF TULSA)

I, Joseph Teichman, President of Sholom Drilling Company, Inc. a corporation of the State of Oklahoma, domesticated in the State of Kansas, being first duly sworn under oath, says: That I have knowledge of the facts, statements, and matters herein contained of the above described well as filed and that the same are true and correct.


Joseph Teichman

Subscribed and sworn to before me this 19th day of February, 1963.


Vernie Hunter
Notary Public

My commission expires: 3-17-64