


STATE OF KANSAS
STATE CORPORATION COMMISSION

Give All Information Completely
Make Required Affidavit
Mail or Deliver Report to:
Conservation Division
State Corporation Commission
800 Bitting Building
Wichita, Kansas

WELL PLUGGING RECORD

NORTH

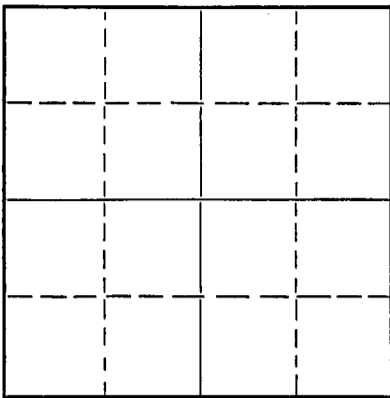

Locate well correctly on above
Section Plat

Ellis County, Sec. 7 Twp. 12 Rge. (E) 20 (W)
Location as "NE/CNW $\frac{1}{4}$ /SW $\frac{1}{4}$ " or footage from lines SE SE SE
Lease Owner Herndon Drilling Company
Lease Name Skaggs Well No. 1
Office Address 423 Mayo Building, Tulsa, Oklahoma
Character of Well (completed as Oil, Gas or Dry Hole) Dry
Date well completed November 10 19 51
Application for plugging filed November 11 19 51
Application for plugging approved November 11 19 51
Plugging commenced November 11 19 51
Plugging completed November 11 19 51
Reason for abandonment of well or producing formation Dry

If a producing well is abandoned, date of last production 19
Was permission obtained from the Conservation Division or its agents before plugging was commenced? Yes

Name of Conservation Agent who supervised plugging of this well Eldon Petty
Producing formation Depth to top Bottom Total Depth of Well 406.0 Feet
Show depth and thickness of all water, oil and gas formations.

OIL, GAS OR WATER RECORDS

CASING RECORD

Formation	Content	From	To	Size	Put In	Pulled Out

Describe in detail the manner in which the well was plugged, indicating where the mud fluid was placed and the method or methods used in introducing it into the hole. If cement or other plugs were used, state the character of same and depth placed, from feet to feet for each plug set.

Filled hole with mud to 240'. Pushed plug to 240' with drill pipe
Mixed 15 sacks cement and poured through drill pipe. Filled hole to 40'.
Pushed plug to 40' with Kelly. Put 1/2 sack hulls on plug. Mixed 10 sacks
cement and filled hole to bottom of cellar with same.

(If additional description is necessary, use BACK of this sheet)

Name of Plugging Contractor Herndon Drilling Company
Address 423 Mayo Building, Tulsa, Oklahoma

STATE OF Oklahoma, COUNTY OF Tulsa, ss.
Jack Herndon (employee of owner) or (owner or operator) of the above-described well,
being first duly sworn on oath, says: That I have knowledge of the facts, statements, and matters herein contained and the log of the above-described well as filed and that the same are true and correct. So help me God.

(Signature)

(Address)

SUBSCRIBED AND SWORN to before me this 20th. day of November, 19 51

My commission expires Sept. 19, 1952 Notary Public.

7-18-2001
124 34

WELL LOG ON SKAGGS #1

Spudding date: 10/27/51
 Date casing set: 11/11/51
 Date rotary completed: 11/10/51
 Date cable completed:

Location:
 Sec. 7-12S-20W
 Ellis County, Kansas

<u>FROM</u>	<u>TO</u>	<u>FORMATION</u>	<u>REMARKS</u>
0	280	Surface	Ran 9 jts. 8-5/8" csg.
280	2550	Shale and Shells	Set @ 280' w/150 sx. cement.
2550	3440	Lime and Shale	
3440	3565	Lime	
3565	3615	Lime and Shale	
3615	4060	Lime	
4060		TOTAL DEPTH	Plugged w/15 sx --240' w/10 sx - 40' to surface.

STATE OF KANSAS
 11-21-1951
 NOV 21 1951
 COUNTY OF ELLIS

Subscribed and sworn to before me this 15th
 day of NOVEMBER, 1951

I certify the above and foregoing to be a true and exact
 copy of the original driller's log on the SKAGGS #1

Elmer Berger
 Notary Public
 My commission expires: August 28, 1955

HERNDON DRILLING COMPANY
 By: *W. E. Rogers*
 Title: *Secretary*

PLUGGING
 FILE SEC 71-12S-20W
 BOOK PAGE 129 LINE 34