

STATE OF KANSAS  
STATE CORPORATION COMMISSION


Form CP-4

Give All Information Completely  
Make Required Affidavit  
Mail or Deliver Report to:  
Conservation Division  
State Corporation Commission  
212 No. Market  
Wichita, Kansas

15-051-30248-00-00  
WELL PLUGGING RECORD

Ellis County, Sec. 3 Twp. 12S Rge. 20W (E) (W)

Location as "NE/CNW/SW" or footage from lines SW SE NE  
Lease Owner Shenandoah Oil Corporation  
Lease Name Emma R. Schoenthaler Well No. 1  
Office Address 608 Mutual Savings Bldg., Fort Worth, Texas 76102  
Character of Well (completed as Oil, Gas or Dry Hole) Dry Hole  
Date well completed 5-7-66 19  
Application for plugging filed 5-7-66 19  
Application for plugging approved 5-7-66 19  
Plugging commenced 5-7-66 19  
Reason for abandonment of well or producing formation Dry Hole

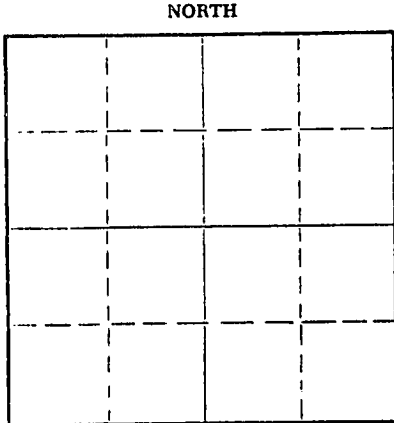

Locate well correctly on above  
Section Plat

If a producing well is abandoned, date of last production \_\_\_\_\_ 19\_\_\_\_  
Was permission obtained from the Conservation Division or its agents before plugging was commenced? yes

Name of Conservation Agent who supervised plugging of this well Leo Massey, Hays, Kansas  
Producing formation \_\_\_\_\_ Depth to top \_\_\_\_\_ Bottom \_\_\_\_\_ Total Depth of Well 3892 Feet  
Show depth and thickness of all water, oil and gas formations.

OIL, GAS OR WATER RECORDS

CASING RECORD

FORMATION	CONTENT	FROM	TO	SIZE	PUT IN	PULLED OUT
				8 5/8"	201'	none

Describe in detail the manner in which the well was plugged, indicating where the mud fluid was placed and the method or methods used in introducing it into the hole. If cement or other plugs were used, state the character of same and depth placed, from \_\_\_\_\_ feet to \_\_\_\_\_ feet for each plug set.

Mudded to 500', set plug, 20 sks. cement  
Mudded to 200', set plug, 20 sks. cement  
Mudded to 40', set plug, 10 sks. cement  
Put 2 sks. in rathole

RECEIVED  
5-11-1966  
MAY 17 1966

(If additional description is necessary, use BACK of this sheet)

Name of Plugging Contractor Leben Drilling, Inc.  
Address Box 486, Great Bend, Kansas 67530

STATE OF KANSAS, COUNTY OF BARTON, ss.  
Leslie Kite

(employee of owner) or (owner or operator) of the above-described well, being first duly sworn on oath, says: That I have knowledge of the facts, statements, and matters herein contained and the log of the above-described well as filed and that the same are true and correct. So help me God.

(Signature)

*Leslie Kite*

P. O. Box 486, Great Bend, Kansas  
(Address)

SUBSCRIBED AND SWORN TO before me this 10th day of May, 1966

*Ulanda Nichols*

Notary Public.

My commission expires April 1, 1967

Ulanda Nichols

15-051-30248-00-00

DRILLER'S LOG

COMPANY: Shenandoah Oil Company  
 CONTRACTOR: LEBEN DRILLING, INC.  
 FARM: EMMA R. SCHOENTHALER #1  
 LOCATION: SW SE NE Sec. 3-12S-20W  
 ELLIS COUNTY, KANSAS  
 COMMENCED: 4-28-66  
 COMPLETED: 5-7-66

0	35	Clay, Post Rock
35	560	Shale
560	1045	Shale, Sand
1045	1255	Sand
1255	1560	Redbed
1560	1607	Anhydrite
1607	1665	Shale
1665	2045	Shale, Lime Streaks
2045	3120	Lime, Shale
3120	3280	Shale, Lime
3280	3892	Lime
	<u>3892</u>	<u>RTD - D. &amp; A.</u>

RECEIVED  
 5-11-1966  
 MAY 17 1966  
 COUNTY OF BARTON

Set 8 5/8" used surface casing @ 201' with 160 sacks Common, 2% cc

I, Leslie Kite, do hereby certify that the above and foregoing is a true and correct copy of the log of the Emma R. Schoenthaler #1 well, located SW SE NE of Section 3, Township 12 South, Range 20 West, Ellis County, Kansas, as reflected by the records of Leben Drilling, Inc.

Leslie Kite

Leslie Kite

STATE OF KANSAS )  
 ) SS  
 COUNTY OF BARTON)

Subscribed and sworn to and before me, a Notary Public, in and for Barton County, Kansas, this 10th day of May, 1966.

Ulanda Nichols

Ulanda Nichols

My Commission Expires:  
 April 1, 1967