

STATE CORPORATION COMMISSION OF KANSAS
OIL & GAS CONSERVATION DIVISION
RECOMPLETION FORM
ACC-2 AMENDMENT TO WELL HISTORY

API NO. 15- ~~H3-02081~~ 15-163-02081-0001

County Rooks

SE SE SW Sec 12 Twp 10S Rge 20 X East West

330 Ft North from Southeast Corner of Section
2970 Ft West from Southeast Corner of Section
(Note: Locate well in section plat below)

Lease Name Sutor 'B' Well # 1

Field Name Marcotte Pool

Name of New Formation Arbuckle

Elevation: Ground 2226 KB 2231
Section Plat

Operator: License # 06854
Name BP Exploration
Address P. O. Box 4587

City/State/Zip Houston, Texas 77210

Purchaser Mobil

Operator Contact Person Harvey J. Dupuy
Phone (713) 552-8836

Designate Type of Original Completion
 New Well Re-Entry Workover
 Oil SWD Temp Abd
 Gas Inj Delayed Comp.
 Dry Other (Core, Water Supply etc.)

Date of Original Completion: 3/29/50


DATE OF RECOMPLETION:
11/10/88 2/29/88 JUN 28 1989
Commenced Completed

Designate Type of Recompletion/Workover:

Deepening Delayed Completion
 Plug Back Re-perforation
 Conversion to Injection/Disposal

Is recompleted production:
 Commingled; Docket No. _____
 Dual Completion; Docket No. _____
 Other (Disposal or Injection)?
Unsuccessful/Plugged back to original zone.

RECEIVED
STATE CORPORATION COMMISSION
6-28-89
CONSERVATION DIVISION
Wichita, Kansas

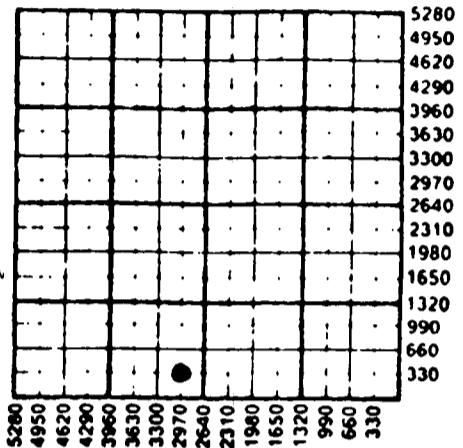

K. C. C. OFFICE USE ONLY
F Letter of Confidentiality Attached
C Wireline Log Received
C Drillers Timelog Received
Distribution
 KCC SWD/Rep NGPA
 KGS Plug Other
(Specify)
6-28-89 (41)

INSTRUCTIONS: This form shall be completed in triplicate and filed with the Kansas Corporation Commission, 200 Colorado Derby Building, Wichita, Kansas 67202, within 120 days of the recompletion of any well. Rules 82-3-107 and 82-3-141 apply. Information on side two of this form will be held confidential for a period of 12 months if requested in writing and submitted with the form. See rule 82-3-107 for confidentiality in excess of 12 months. One copy of any additional wireline logs and driller's time logs (not previously submitted) shall be attached with this form. Submit ACC-4 prior to or with this form for approval of commingling or dual completions. Submit OP-4 with all plugged wells. Submit OP-111 with all temporarily abandoned wells. NOTE: Conversion of wells to either disposal or injection must receive approval before use; submit form U-1.

All requirements of the statutes, rules and regulations promulgated to regulate the oil and gas industry have been fully complied with and the statements herein are complete and correct to the best of my knowledge.

Signature C. E. Strange Title Petroleum Engineering Supervisor (East) Date 6/19/89
Subscribed and sworn to before me this 19th day of June 19 89

Notary Public Kathleen A. Lovely Date Commission Expires 3-18-92
KATHLEEN A. LOVELY
Notary Public
State of Texas
Comm. Expires 3-18-92

FORM ACC-2
5/88

*Deepening was unsuccessful.

