


STATE OF KANSAS  
STATE CORPORATION COMMISSION

Give All Information Completely  
Make Required Affidavit  
Mail or Deliver Report to:  
Conservation Division  
State Corporation Commission  
211 No. Broadway  
Wichita, Kansas

## WELL PLUGGING RECORD

NORTH

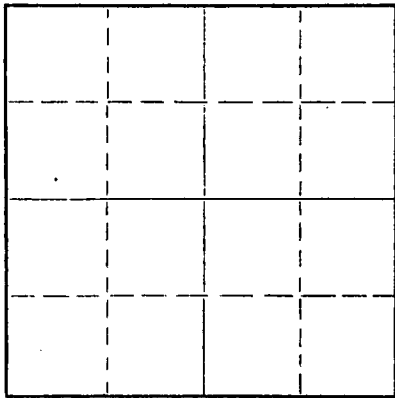

Locate well correctly on above  
Section Plat

Rooks County. Sec. 33 Twp. 10S Rge. 20 (E) W (W)  
Location as "NE/CNW/SW" or footage from lines 1650' from West and 330'  
Lease Owner \_\_\_\_\_ North lines  
Lease Name C. E. Allphin Well No. 9  
Office Address Drawer 98 - Plainville, Kansas  
Character of Well (completed as Oil, Gas or Dry Hole) Test  
Date well completed August 4, 1955  
Application for plugging filed April 16, 1958  
Application for plugging approved April 18, 1958  
Plugging commenced May 21, 1958  
Plugging completed May 23, 1958  
Reason for abandonment of well or producing formation \_\_\_\_\_  
Field Test Completed  
If a producing well is abandoned, date of last production \_\_\_\_\_ 19\_\_\_\_  
Was permission obtained from the Conservation Division or its agents before plugging was commenced? Yes

Name of Conservation Agent who supervised plugging of this well Eldon Petty  
Producing formation None Depth to top \_\_\_\_\_ Bottom \_\_\_\_\_ Total Depth of Well 3,785 Feet  
Show depth and thickness of all water, oil and gas formations.

## OIL, GAS OR WATER RECORDS

## CASING RECORD

FORMATION	CONTENT	FROM	TO	SIZE	PUT IN	PULLED OUT
				8 5/8"	221'	None
				5 1/2"	2,338'	2,338'

Describe in detail the manner in which the well was plugged, indicating where the mud fluid was placed and the method or methods used in introducing it into the hole. If cement or other plugs were used, state the character of same and depth placed, from \_\_\_\_\_ feet to \_\_\_\_\_ feet for each plug set.

Checked the hole and found it open. Loaded the hole with 10 sacks of mud. Pulled 63 joints of casing and pumped in 20 sacks of cement to 550'. Pulled 10 joints and pumped in 20 sacks of cement to 240'. Pulled the rest of the casing (8 joints). Cleared the hole and checked fluid to 50'. Mudded the hole to 35', set a rock bridge to 30' and ran 10 sacks of cement to the base of the cellar.

RECEIVED  
STATE CORPORATION COMMISSION  
6-2-1958  
JUN 2 1958  
CONSERVATION DIVISION  
Wichita, Kansas

(If additional description is necessary, use BACK of this sheet)  
Name of Plugging Contractor West Supply Co., Inc.  
Address Chase, Kansas

STATE OF KANSAS, COUNTY OF ROOKS, ss.  
L. E. Powell (employee of owner) or (owner or operator) of the above-described well, being first duly sworn on oath, says: That I have knowledge of the facts, statements, and matters herein contained and the log of the above-described well as filed and that the same are true and correct. So help me, God.

(Signature)

Drawer 98 - Plainville, Kansas

(Address)

SUBSCRIBED AND SWORN TO before me this 28th day of May, 19 58My commission expires December 2, 1961

Notary Public.

State Corp. Comm. ✓  
RFD  
File

PLUGGING  
FILE SEC. 33 T. 10 R. 20W  
BOOK PAGE 94 LINE 11