

STATE OF KANSAS
STATE CORPORATION COMMISSION
200 Colorado Derby Bldg.
Wichita, Kansas 67202

RECEIVED
STATE CORPORATION COMMISSION Form CP-4
10-15-1982
OCT 15 1982
Rev. 12-15-80
CONSERVATION DIVISION
Wichita, Kansas

WELL PLUGGING RECORD

Give All Information Completely
Make Required Affidavit

COUNTY Rooks SEC. 23 TWP. 10S RGE. 20 W
Location as in quarters or footage from lines:
SE NW NE

		0	
	23		

Locate Well
correctly on above
Section Platt.

Lease Owner Champlin Petroleum Company
Lease Name ROGERS 'B' Well No. 5
Atrium Towers No. _____
Office Address 6441 N.W. Grand Blvd. - Suite 300 - Okla. City, OK
Character of Well (Completed as Oil, Gas or Dry Hole): SWD 73116
Date Well Completed 12-14-51
Application for plugging filed September 15, 1982
Plugging commenced 10-6-82
Plugging completed 10-6-82
Reason for abandonment of well or producing formation _____

Condition of casing _____
Was permission obtained from the Conservation Division or it's
Agent's before plugging was commenced? Yes

Name of Conservation Agent who supervised plugging of this well Dennis Hamel
Producing formation SWD Depth to top 3971' bottom 4279' T.D. 4279'
Show depth and thickness of all water, oil and gas formations.

OIL, GAS OR WATER RECORDS Casing Record

Formation	Content	From	To	Size	Put in	Pulled Out
				8-5/8"	138'	None
Lower Arbuckle	Salt water	3971	4279	5-1/2"	3971'	None

Describe in detail the manner in which the well was plugged, indicating where the mud fluid was placed and the method or methods used in introducing it into the hold. If cement or other plugs were used, state the character of same and depth placed, from _____ feet to _____ feet for each plug set.

Ran 1100' of 2-1/2" tubing - Pulled tubing up to 1000' and circulated 100 sax of 50/50 Poz 6% Gel and 3% CC with 2 sax of hulls. Cement circulated to surface and held.

(If additional description is necessary, use BACK of this sheet)
Name of Plugging Contractor Allied Cementing Company (Russell, Kansas)

STATE OF Oklahoma COUNTY OF Oklahoma, ss.
CHAMPLIN PETROLEUM COMPANY (employee of owner) or (owner or operator) of the above-described well, being first duly sworn on oath, says: That I have knowledge of the facts, statements, and matters herein contained and the log of the above-described well as filed and that the same are true and correct. So help me God.


(Signature) [Signature]
6441 N.W. Grand Blvd.
Atrium Towers North (Address) #300
Oklahoma City, OK 73116

SUBSCRIBED AND SWORN TO before me this 13th day of October, 19 82

[Signature]
Notary Public.

My Commission expires: 10-08-83

15-163-03255-00-00

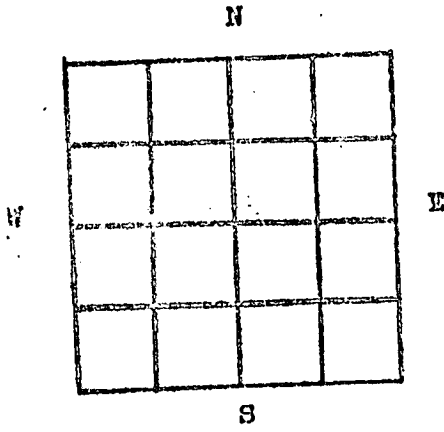

COUNTY Rooks SEC. 23 TWP. 103 RGE. 20W
 COMPANY OPERATING Champlin Refining Company
 OFFICE ADDRESS Box 552 - Erid, Oklahoma
 FARM NAME Rogers WELL NO. B #15
 WELL LOCATED 990' from North Line & 1650' from
 East Line of the NE/4
 CHARACTER OF WELL Saltwater Disposal

DRILLING COMMENCED October 11, 1951 DRILLING COMPLETED October 27, 1951

Size	Weight	Thds	Make	Ftg	Ins.	Amount Pulled	Catant
8-5/8"	32#	8 Rd	National	138'	-	-	135 sacks
5-1/2"	15.5#	8 Rd	National	377'	-	-	600 sacks

FORMATION RECORD

	<u>TOPS</u>	<u>BOTTOM</u>	<u>TOP</u>	<u>BOTTOM</u>
Surface Clay-Sand-Shells	0	138	Elevation: 2262' D.F.	
Shale	138	438		
Shale-Sand	438	880		
Shale-Sand-Salt	800	1320		
Shale-Shells-Redbed	1320	1645		
Anhydrite	1645	1700		
Redbed-Shale	1700	1800		
Redbed-Shale-Shells	1800	2000		
Shale-Lime	2000	3060		
Broken Lime-Shale	3060	3210		
Lime-Shale	3210	3419		
Lime	3419	3514		
Lime-Shale	3514	3569		
Lime	3569	3653		
Lime-Shale	3653	3693		
Lime	3693	3728		
Lime-Conglomerate	3728	3775		
Conglomerate	3775	3816		
Conglomerate-Arbuckle	3816	3870		
Arbuckle	3870	3899		
Lime	3899	4279		

RECEIVED
 STATE CORPORATION COMMISSION
 SEP 17 1952
 CONSERVATION DIVISION
 Wichita, Kansas

GEOLOGICAL TOPS

Topoka	3243
Heebner	3455
Toronto	3476
Lansing-Kansas City	3491
Base-Kansas City	3706
Conglomerate	3733
Arbuckle	3824

[Signature]
 Superintendent

Subscribed and sworn to before me
 this 14th day of January, 1952

August 14, 19