

STATE OF KANSAS
STATE CORPORATION COMMISSION

Form CP-4

Give All Information Completely
Make Required Affidavit
Mail or Deliver Report to:
Conservation Division
State Corporation Commission
P. O. Box 17027
Wichita, Kansas 67217
NORTH

WELL PLUGGING RECORD

Rooks County, Sec. 23 Twp. 10S Rge. 20 (E) (W)

Location as "NE/CNWSW2" or footage from lines C NW NW NE

Lease Owner Champlin Petroleum Company

Lease Name Rogers "B" Well No. 1

Office Address 6441 N.W. Grand, #300, Oklahoma City, OK 73116

Character of Well (completed as Oil, Gas or Dry Hole) Oil

Date well completed June 26 19 81

Application for plugging filed June 22 19 82

Application for plugging approved June 29 19 82


Plugging commenced Sept 8 19 82

Plugging completed Sept 9 19 82

Reason for abandonment of well or producing formation Uneconomical to produce

If a producing well is abandoned, date of last production June 19 75

Was permission obtained from the Conservation Division or its agents before plugging was commenced? yes

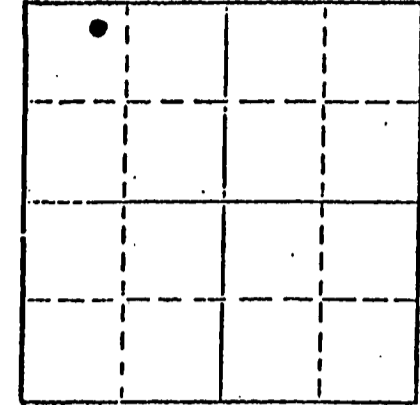

Locate well correctly on above Section Plat

Name of Conservation Agent who supervised plugging of this well D. Hamel

Producing formation Arbuckle Depth to top 3775 Bottom 3776 Total Depth of Well 3776 Feet

Show depth and thickness of all water, oil and gas formations.

OIL, GAS OR WATER RECORDS

CASING RECORD

FORMATION	CONTENT	FROM	TO	SIZE	PUT IN	PULLED OUT
Arbuckle		3775	3776	8 5/8"	210'	None
				5 1/2"	3775'	None

Describe in detail the manner in which the well was plugged, indicating where the mud fluid was placed and the method or methods used in introducing it into the hole. If cement or other plugs were used, state the character of same and depth placed, from _____ feet to _____ feet for each plug set.

Pump 50 sacks 50-50 Pozmix cement w/6% gel and 2 sacks cottonseed hulls down the casing followed by 20 sacks gel and 125 sacks 50-50 Pozmix cement w/6% gel and 2 sacks cottonseed hulls. Pressured to 225# and shut in. Hook up to 8 5/8" x 5 1/2" annulus, pump 100 sacks 50-50 Pozmix cement w/6% gel and 2 sacks cottonseed hulls. Pressure to 425# and shut in. Cut casing off 4 1/2' below ground level, fill w/dry cement and cap w/1 sack dry cement.
WELL IS P&A.

RECEIVED
STATE CORPORATION COMMISSION
9-27-1982
SEP 27 1982
CONSERVATION DIVISION
Wichita Kansas

Name of Plugging Contractor Halliburton
Address _____

STATE OF Oklahoma COUNTY OF Oklahoma
J. W. Meyers (employee of owner) or (owner or operator) of the above-described

well, being first duly sworn on oath, says: That I have knowledge of the facts, statements, and matters herein contained and the log of the above-described well as filed and that the same are true and correct. So help me God.

(Signature) _____


6441 N.W. Grand, #300, Oklahoma City, OK 73116
(Address)

Subscribed and sworn to before me this 23rd day of September 19 82

My commission expires 10/08/83

Notary Public

15-163-02182-00-00

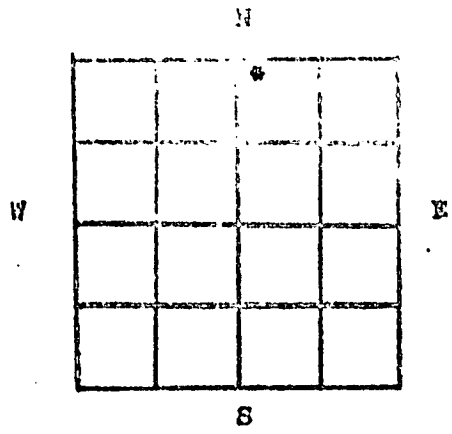

CO. Rooks Sec. 23 T. 10S R. 20W
 COMPANY OPERATING Champlin Refining Company
 OFFICE ADDRESS P. O. Box 552 - Mid, Oklahoma
 FARM NAME Marshall Rogers WELL NO. 1 "B"
 WELL LOCATED 330' from North Line and 2310' from
East Line of NE/4 Sec. 23-10S-20W, Rooks County, Kansas
 CHARACTER OF WELL Oil

DRILLING COMMENCED June 16, 1951 DRILLING COMPLETED June 26, 1951

Size	Weight	Thds	Mkts	ft	Inn	Amount Pulled	Cost
8-5/8"	24#	8 rd	Used	210	-	-	160 sacks
5-1/2"	14#	8 rd	National Tube (used)	3275	-	-	150 sacks

FORMATION RECORD

	<u>TOPS</u>	<u>BOTTOM</u>	<u>TOP</u>	<u>BOTTOM</u>
Shale and Sand	0	651		
Shale & Shells	651	1515		
Shale and Redbed	1515	1653		
Anhydrite	1653	1690		
Shale & Redbed	1690	1770		
Shale, Anhydrite & Broken lime	1770	2068		
Shale and Lime	2068	2280		
Shale and Broken Lime	2280	2445		
Shale & Lime	2245	2700		
Shale and Broken Lime	2700	2815		
Shale and Lime	2815	3497		
Lime	3497	3758		
Simpson Shale	3758	3775		
Lime	3775	3777 T.D.		

Elevation: 2221' from Derrick floor.

GEOLOGICAL TOPS

Heebner	3445
Lansing	3484
Conglomerate	3717
Simpson	3756
Arbuckle	3775

J. C. ...
 Print name

Subscribed and sworn to before me
 this 10 day of August, 1951

Mr. C. ...
 Aug. 14, 1954