


STATE OF KANSAS
STATE CORPORATION COMMISSION

WELL PLUGGING RECORD

Give All Information Completely
Make Required Affidavit
Mail or Deliver Report to:
Conservation Division
State Corporation Commission
800 Bitting Building
Wichita, Kansas

NORTH

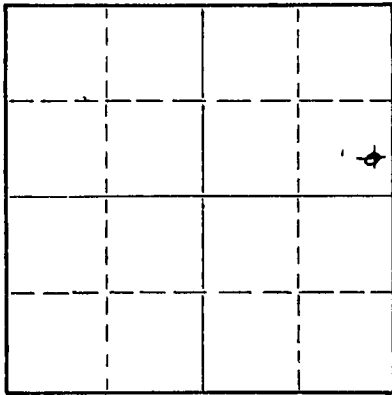

Locate well correctly on above
Section Plat

Rooks County. Sec. 28 Twp. 10 Rge. 20 (E) (W)
Location as "NE/CNW&SW" or footage from lines NE SE NE/4
Lease Owner Virginia Drilling Co Inc et al
Lease Name Williams Well No. 1
Office Address 712 Brown Bldg. - Wichita 2, Kansas
Character of Well (completed as Oil, Gas or Dry Hole) dry hole
Date well completed Dec. 3, 1956 19
Application for plugging filed " 19
Application for plugging approved " 19
Plugging commenced " 19
Plugging completed Dec. 4, 1956 19
Reason for abandonment of well or producing formation _____

If a producing well is abandoned, date of last production _____ 19
Was permission obtained from the Conservation Division or its agents before plugging was commenced? yes

Name of Conservation Agent who supervised plugging of this well Eldon Petty
Producing formation _____ Depth to top _____ Bottom _____ Total Depth of Well 3781 Feet
Show depth and thickness of all water, oil and gas formations.

OIL, GAS OR WATER RECORDS

CASING RECORD

FORMATION	CONTENT	FROM	TO	SIZE	PUT IN	PULLED OUT
		0	234	8 5/8"	236	none

Describe in detail the manner in which the well was plugged, indicating where the mud fluid was placed and the method or methods used in introducing it into the hole. If cement or other plugs were used, state the character of same and depth placed, from _____ feet to _____ feet for each plug set.

Mudded to 220 ft - set plug w/ 15 sx cement - 1/2 sx bulls

Mudded to 40 ft - set plug w/ 10 sx cement - 1/2 sx bulls

RECEIVED
12-11-1956

(If additional description is necessary, use BACK of this sheet)

Name of Plugging Contractor Virginia Drilling Co Inc.
Address 712 Brown Bldg - Wichita 2, Kansas

STATE OF Kansas, COUNTY OF Sedgwick, ss.
S. A. Murphy (employee of owner) or (owner or operator) of the above-described well, being first duly sworn on oath, says: That I have knowledge of the facts, statements, and matters herein contained and the log of the above-described well as filed and that the same are true and correct. So help me God.

(Signature) S. A. Murphy
712 Brown Bldg. - Wichita 2, Kansas
(Address)

SUBSCRIBED AND SWORN to before me this 10th day of December, 1956

Murphy
Notary Public.

My commission expires February 5, 1957.

PLUGGING
NO 28 T. 10 R. 20 W
PAGE 123 OF 45

WILLIAMS #1- NE SE NE/4 Section 28-10-20 Rooks County, Kansas
Company - Virginia Drilling Co., Inc.-Brooks Hall et al
Contractor - Virginia Drilling Co Inc.
Commenced - November 22, 1956
Completed - December 4, 1956
Elevation - 2171 DF
Total Depth - 3781 ft.

8 5/8" set at 234 ft.
Dry hole

<u>FORMATION</u>	<u>DEPTH</u>	
Rock-clay	0- 105	
Clay-sand	105- 200	
Clay-shale	200- 234	TOPS:
Red bed - shale	234-1000	
Sand-shale	1000-1410	3438 - Heebner
Salt-shale-shells	1410-1600	3467 - Dodge lime
Shale-shells	1600-1650	3478 - Kansas City
Anhydrite	1650-1685	3720 - Detrital zone
Shale-shells	1685-2205	3740 - Conglomerate
Lime-shale	2205-2340	
Lime	2340-2450	
Lime-shale	2450-3325	
Lime-conglomerate	3325-3781 TD	

S. A. Murphy
S. A. Murphy

Subscribed and sworn to before me, a Notary Public,
this 7th day of December, 1956.

Murlee Hawkins
Notary Public-Murlee Hawkins

My commission expires: Febr. 5, 1957

FILED
12-11-1956

28 10 20 W
123 45