

STATE OF KANSAS
STATE CORPORATION COMMISSION

Give All Information Completely
Make Required Affidavit
Mail or Deliver Report to:
Conservation Division
State Corporation Commission
800 Bittling Building
Wichita, Kansas

WELL PLUGGING RECORD

Rooks County, Sec. 28 Twp. 10 Rge. 20 (E) (W)

Location as "NE/CNW/SW" or footage from lines SW SW SW SEW

Lease Owner I. O. Miller

Lease Name Thomas #1 Well No. 1

Office Address P. O. Box 274, Ellis, Kansas.

Character of Well (completed as Oil, Gas or Dry Hole) Dry Hole

Date well completed March 26, 1955 19

Application for plugging filed March 26, 1955 19

Application for plugging approved March 26, 1955 19


Plugging commenced March 26, 1955 P. M. 19

Plugging completed March 26, 1955 about 5 P. M. 19

Reason for abandonment of well or producing formation Dry Hole

If a producing well is abandoned, date of last production 19

Was permission obtained from the Conservation Division or its agents before plugging was commenced? Yes

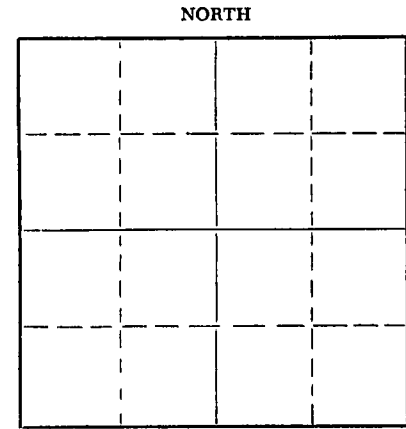

Locate well correctly on above Section Plat

Name of Conservation Agent who supervised plugging of this well Eldon Petty

Producing formation None Depth to top Bottom Total Depth of Well Feet

Show depth and thickness of all water, oil and gas formations.

OIL, GAS OR WATER RECORDS

CASING RECORD

FORMATION	CONTENT	FROM	TO	SIZE	PUT IN	PULLED OUT

Describe in detail the manner in which the well was plugged, indicating where the mud fluid was placed and the method or methods used in introducing it into the hole. If cement or other plugs were used, state the character of same and depth placed, from feet to feet for each plug set.

Hole filled to 230' from top with heavy mud and bottom plug set.
1/2 sack of hulls put on top of plug, followed by 15 sacks cement.
Hole filled with heavy mud to 40' from top and set top plug. 1/2 sack of hulls placed above plug, followed by 10 sacks of cement.

REC
STATE CORP. COM.
6-3-1955
CONSERVATION DIVISION
WICHITA, KANSAS

(If additional description is necessary, use BACK of this sheet)

Name of Plugging Contractor Virginia Drilling Company, Inc.

Address 701 Brown Building, Wichita, Kansas.

STATE OF Kansas, COUNTY OF Rooks, ss. J. O. Tribble, (employee of owner or (owner or operator) of the above-described well, being first duly sworn on oath, says: That I have knowledge of the facts, statements, and matters herein contained and the log of the above-described well as filed and that the same are true and correct. So help me God.

(Signature) James O Tribble Demar, Kansas. (Address)

SUBSCRIBED AND SWORN TO before me this 31 st day of May, 19 55

My commission expires August 10, 1958 Notary Public.

PLUGGING
FILE SEC 28 T 10 R 20W
BOOK PAGE 29

May 28, 19 55.

State Corporation Commission
Conservation Division,
Wichita, Kansas.

Lease Owner: I. O. Miller
Lease: Thomas # 1.
Pool:
Well number: Thomas # 1
Description: SW SW ~~SW~~ SE 1/4
Sec. 28-10-20 W

ES
KCC
11/13/09

Gentlemen:-

The following is a log of the above captioned
dry hole:-

Elevation 2144 DF.

Heebner 3401 - 1257
Toronto 3420 - 1276
Lansing KC 3438 - 1294
Arbuckle 3748- 1604
T. D. 3770- 1626

This log is attached to well Plugging Application Form.

Yours truly,

I. O. MILLER

By *James O. Lillie*
Asst. Sup't

RECEIVED
STATE CORPORATION COMMISSION
JUN 3 - 1955
CONSERVATION DIVISION
Wichita, Kansas

PLUGGING
FILE SEC 28-10-20 W
BOOK PAGE 107-111 29