


STATE OF KANSAS  
STATE CORPORATION COMMISSION

Give All Information Completely  
Make Required Affidavit  
Mail or Deliver Report to:  
Conservation Division  
State Corporation Commission  
212 No. Market  
Wichita, Kansas

WELL PLUGGING RECORD

NORTH

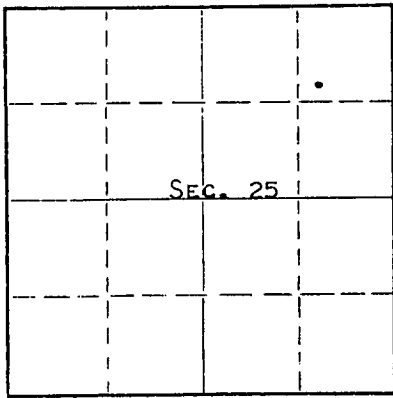

Locate well correctly on above  
Section Plat

ROOKS County. Sec. 25 Twp 10s Rge. 20 X(2)X (W)  
Location as "NE/CNW/SW" or footage from lines APP. SW NE NE  
Lease Owner PETROLEUM, INC.,  
Lease Name SUTOR Well No. L-1  
Office Address R.R. #2, GREAT BEND, KANSAS  
Character of Well (completed as Oil, Gas or Dry Hole) DRY HOLE  
Date well completed OCTOBER 20 19 68  
Application for plugging filed OCTOBER 20 19 68  
Application for plugging approved OCTOBER 20 19 68  
Plugging commenced OCTOBER 20 19 68  
Plugging completed OCTOBER 20 19 68  
Reason for abandonment of well or producing formation NO PRODUCIBLE ZONE

If a producing well is abandoned, date of last production NONE 19  
Was permission obtained from the Conservation Division or its agents before plugging was commenced? YES

Name of Conservation Agent who supervised plugging of this well LEO MASSEY  
Producing formation \_\_\_\_\_ Depth to top \_\_\_\_\_ Bottom \_\_\_\_\_ Total Depth of Well 376.9 Feet  
Show depth and thickness of all water, oil and gas formations.

OIL, GAS OR WATER RECORDS

CASING RECORD

FORMATION	CONTENT	FROM	TO	SIZE	PUT IN	PULLED OUT
				8-5/8"	247	NONE

Describe in detail the manner in which the well was plugged, indicating where the mud fluid was placed and the method or methods used in introducing it into the hole. If cement or other plugs were used, state the character of same and depth placed, from \_\_\_\_\_ feet to \_\_\_\_\_ feet for each plug set.

HEAVY MUD TO 800', FOLLOWED WITH 70 SACKS CEMENT. MUD TO 240', FOLLOWED WITH 20 SACKS CEMENT. HEAVY MUD TO 40', FOLLOWED WITH 10 SACKS CEMENT TO BASE OF WELL CELLAR.

RECEIVED  
STATE CORPORATION COMMISSION  
OCT 28 1968  
CONSERVATION DIVISION  
Wichita, Kansas

(If additional description is necessary, use BACK of this sheet)

Name of Plugging Contractor GARVEY DRILLING COMPANY  
Address R.R. #2, GREAT BEND, KANSAS

STATE OF KANSAS, COUNTY OF BARTON, ss.  
MONTE CHADD (employee of owner) or (owner/operator) of the above-described well, being first duly sworn on oath, says: That I have knowledge of the facts, statements, and matters herein contained and the log of the above-described well as filed and that the same are true and correct. So help me God. MONTE CHADD, DIST. PROD. SUPT.

(Signature) *Monte Chadd*  
R.R. #2, GREAT BEND, KANSAS  
(Address)

SUBSCRIBED AND SWORN TO before me this 25 day of OCTOBER, 19 68

My commission expires MAY 28, 1969

*Richard H. Dumble*  
Notary Public.

# WELL LOG

COMPANY Petroleum, Inc.

SEC. 25 T. 10S R. 20W

FARM Sutor

NO. L-1

LOC. SW NE NE


TOTAL DEPTH 3769'

COUNTY Rooks Co., Kansas

COMM. 10-13-68

COMP. 10-20-68

CONTRACTOR Garvey Drilling Company

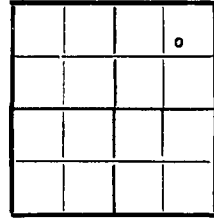

CASING 8 5/8" @ 247' w/195 sx

ELEVATION 2193' KB

PRODUCTION D & A

FIGURES INDICATE BOTTOM OF FORMATIONS

- 160' Sand & Post Rock
- 247' Blue Shale & Shells
- 1361' Shale & Sand
- 1595' Shale & Shells
- 1630' Anhydrite
- 2925' Shale & Lime
- 3390' Lime & Shale
- 3445' Lime
- 3530' Lime & Shale
- 3761' Lime
- 3769' Arbuckle & Lime
- 3769' RTD

RECEIVED  
 STATE CORPORATION COMMISSION  
 OCT 28 1968  
 CONSERVATION DIVISION  
 Wichita, Kansas

State of Kansas }  
 County of Barton } ss

I, Eunice McEachern of Garvey Drilling Company

upon oath state the above and foregoing is a true and correct copy of the log of the Sutor L-1 well.

Eunice McEachern

Subscribed and sworn to before me this 23 day of October 19 68

My Commission Expires: November 5th, 1969

Richard Doep  
 NOTARY PUBLIC