


WELL PLUGGING RECORD

Give All Information Completely  
Make Required Affidavit  
Mail or Deliver Report to:  
Conservation Division  
State Corporation Commission  
800 Bittling Building  
Wichita, Kansas

NORTH

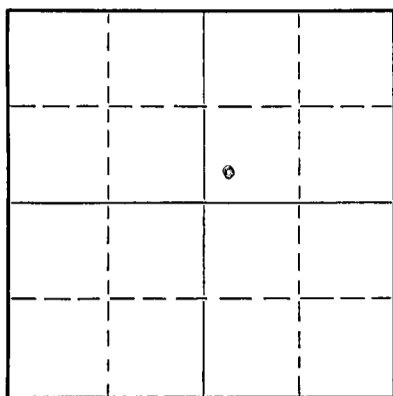

Locate well correctly on above Section Plat

Rooks \_\_\_\_\_ County. Sec. 25 Twp. 10S Rge. (E) 20 (W) \_\_\_\_\_  
Location as "NE/CNW $\frac{1}{4}$ /SW $\frac{1}{4}$ " or footage from lines SW $\frac{1}{4}$  SW $\frac{1}{4}$  NE $\frac{1}{4}$   
Lease Owner Birmingham-Bartlett Drilling Co.  
Lease Name Sutor "C" Well No. 1  
Office Address 300 Kaufman Building, Wichita 2, Kansas  
Character of Well (completed as Oil, Gas or Dry Hole) Dry Hole  
Date well completed November 29 19 50  
Application for plugging filed December 4 19 50  
Application for plugging approved December 7 19 50  
Plugging commenced December 8 19 50  
Plugging completed December 13 19 50 X  
Reason for abandonment of well or producing formation Drilled as dry hole  
If a producing well is abandoned, date of last production \_\_\_\_\_ 19 \_\_\_\_\_  
Was permission obtained from the Conservation Division or its agents before plugging was commenced? Yes

Name of Conservation Agent who supervised plugging of this well Eldon Petty, Box 326, Hays, Kansas  
Producing formation Arbuckle Depth to top 3731 Bottom \_\_\_\_\_ Total Depth of Well 3738 Feet  
Show depth and thickness of all water, oil and gas formations.

OIL, GAS OR WATER RECORDS

CASING RECORD

Formation	Content	From	To	Size	Put In	Pulled Out
	Log of well as drilled attached.					

Describe in detail the manner in which the well was plugged, indicating where the mud fluid was placed and the method or methods used in introducing it into the hole. If cement or other plugs were used, state the character of same and depth placed, from 3738 feet to surface feet for each plug set.

Hole filled with sand from 3738 to 3725 feet; four sacks of cement placed in hole with dump bailer forming cement plug from 3725 to 3693; Filled hole with mud from 3693 to 170 feet; Rock bridge installed between 170 feet to 160 feet; sixteen sacks of cement poured in hole, forming cement plug from 160 feet to 115 feet; hole filled with mud from 115 feet to 35 feet. Rock bridge installed from 35 feet to 30 feet; hole capped with ten sacks of cement; plugging complete.

RECEIVED  
STATE CORPORATION COMMISSION  
1-12-1951  
JAN 12 1951  
CONSERVATION DIVISION  
WICHITA, KANSAS

(If additional description is necessary, use BACK of this sheet)

Correspondence regarding this well should be addressed to Birmingham-Bartlett Drilling Co.  
Address 300 Kaufman Building, Wichita 2, Kansas

STATE OF KANSAS, COUNTY OF RUSSELL, Barnes & Sons Pipe Pulling Co. representative of Barnes & Sons Pipe Pulling Co., pluggers of above well,  
being first duly sworn on oath, says: That I have knowledge of the facts, statements, and matters herein contained and the log of the above-described well as filed and that the same are true and correct. So help me God. BARNES & SONS PIPE PULLING CO.  
(Signature) X By J. B. Barnes  
Russell, Kansas  
(Address)

SUBSCRIBED AND SWORN to before me this 12 day of December 1950

My commission expires Nov. 17, 1952 Notary Public

PLUGGING  
FILE SEC 26 T 10 R 20W  
BOOK PAGE 47 LINE 9

OPERATOR &amp; CONTRACTOR: Birmingham-Bartlett Drilling Co.

SUTOR "C" NO. 1 WELL

LOCATION: SW<sub>4</sub> SW<sub>4</sub> NE<sub>4</sub> Sec. 25-100-204 SPUDDED: 11-10-50  
Rocks County, Kansas  
COMPLETED: 11-21-50

SURFACE CASING: Ran 175' 8-5/8" casing cemented @ 173' with 125 sacks cement and 1 c.c.

OIL STRING: Ran 119 jts., 5 1/2" O.D. 1 1/2" 8 rd. thd. smls. casing cemented @ 3733', with 150 sacks cement.

LOG

(Figures indicate bottom of formation)

0 to 20	Sand
50	Post rock
1050	Shale and shells
1260	Sand
1585	Shale and shells
1620	Anhydrite
2110	Shale and shells
2485	Broken lime
2810	Shale and shells
2895	Lime and shale
3030	Shale and shells
3150	Shale and lime
3235	Shale and shells
3350	Shale and lime
3390-	Lime
3423	Shale and lime
3707	Lime
3732	Shale and sand
3734	Lime
3734	Total Depth.

The undersigned Richard Hindery of the BIRMINGHAM-BARTLETT DRILLING CO. hereby certifies that the above is a true and correct log of the formations encountered in drilling the Sutor "C" #1 well as shown on the daily drilling reports.

BIRMINGHAM-BARTLETT DRILLING CO.

BY Richard Hindery

Subscribed and sworn before me  
this 24th day of November, 1950.

Lawrence E. Ginger  
Notary Public

SEARCHED  
INDEXED  
SERIAL 1-12-1951

CONFIRMED  
NOTARY PUBLIC

My commission expires November 29, 1950.

