


WELL PLUGGING RECORD

Give All Information Completely  
Make Required Affidavit  
Mail or Deliver Report to:  
Conservation Division  
State Corporation Commission  
800 Bittling Building  
Wichita, Kansas

NORTH

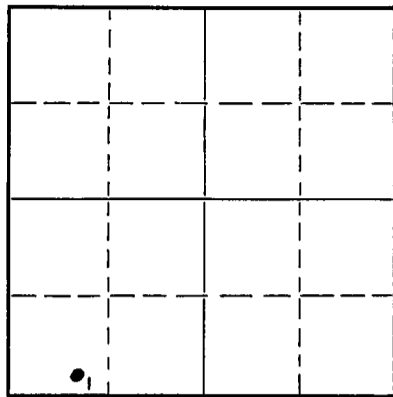

Locate well correctly on above Section Plat

Rooks County Sec. 25 Twp. 10 Rge. 20 (E) (W)  
Location as "NE/CNW $\frac{1}{4}$ SW $\frac{1}{4}$ " or footage from lines C-SE/4 SW/4 SW/4  
Lease Owner Midstates Oil Corporation  
Lease Name Imogene Ouderkirk Well No. 5  
Office Address 518 National Bank of Tulsa Bldg., Tulsa, Oklahoma  
Character of Well (completed as Oil, Gas or Dry Hole) Dry Hole  
Date well completed December 27, 19 50  
Application for plugging filed June 8, 19 51  
Application for plugging approved June 11, 19 51  
Plugging commenced July 27, 19 51  
Plugging completed August 9, 19 51  
Reason for abandonment of well or producing formation Dry Hole

If a producing well is abandoned, date of last production 19  
Was permission obtained from the Conservation Division or its agents before plugging was commenced? Yes

Name of Conservation Agent who supervised plugging of this well Mr. Eldon Petty  
Producing formation Depth to top Bottom Total Depth of Well 3733 Feet  
Show depth and thickness of all water, oil and gas formations.

OIL, GAS OR WATER RECORDS

CASING RECORD

Formation	Content	From	To	Size	Put In	Pulled Out
Arbuckle Lime	Dry	3725'	3734'	10-3/4"	301'	None
				7"	3725'	2237'

Describe in detail the manner in which the well was plugged, indicating where the mud fluid was placed and the method or methods used in introducing it into the hole. If cement or other plugs were used, state the character of same and depth placed, from feet to feet for each plug set.

Plugged back from 3330' 3300' with crushed rock. From 3300' to 3280' 5 sacks cement.  
From 3280' to 250' heavy mud pumped in. From 250' to 240' permanent rock bridge.  
From 240' to 200' 20 sacks cement. From 200' to 35' heavy mud pumped in. From 35' to bottom of cellar 10 sacks cement.

8-21-1951

(If additional description is necessary, use BACK of this sheet)

Correspondence regarding this well should be addressed to Midstates Oil Corporation  
Address 518 National Bank of Tulsa Building, Tulsa, Oklahoma

STATE OF Oklahoma, COUNTY OF Tulsa, ss.  
W. H. Barclay (employee of owner) or (owner or operator) of the above-described well,  
being first duly sworn on oath, says: That I have knowledge of the facts, statements, and matters herein contained and the log of the above-described well as filed and that the same are true and correct. So help me God.


(Signature) *W. H. Barclay*

(Address)

SUBSCRIBED AND SWORN to before me this 20th day of August, 19 51

My commission expires March 21, 1955

*Betty June Hawes* Notary Public

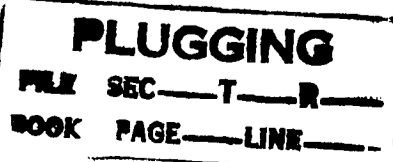

<u>Formation</u>	<u>Top</u>	<u>Bottom</u>
Rock	0	40
Rock & Sandy Clay	40	92
Shale, sand	92	302
Shale, shell	302	505
Shale	505	750
Sand, Shale	750	1000
Sand	1000	1275
Shale, shells	1275	1502
Shale, lime, shells	1502	1550
Anhydrite	1550	1584
Anhydrite	1584	1595
Red bed, shale	1595	1830
Shale, shells	1830	2040
Shale	2040	2098
Lime, shale	2098	2235
Lime, shale	2235	2775
Shale	2775	2905
Lime, shale	2905	3045
Shale	3045	3130
Lime, shale	3130	3363
Shale	3363	3407
Lime, shale	3407	3661
Conglomerate	3661	3703
Simpson Shale	3703	3709
Simpson Shale	3709	3725
Arbuckle Lime	3725	3726
Arbuckle Lime	3726	3729 $\frac{1}{2}$
Arbuckle Lime	3729	3734
Total Depth		3734

Signed: W. H. Barclay  
Date: August 20, 1951