

15-163-03258-0000

STATE OF KANSAS
STATE CORPORATION COMMISSION


WELL PLUGGING RECORD

Give All Information Completely
Make Required Affidavit
Mail or Deliver Report to:
Conservation Division
State Corporation Commission
800 Bittling Building
Wichita, Kansas

Rooks County. Sec. 27 Twp. 10S Rge. 20 (E) W (W)

Location as "NE/CNWxSWx" or footage from lines. C W 1/2 W 1/2 NE 1/4
Lease Owner The Derby Oil Company
Lease Name Annon Well No. 2
Office Address P.O. Box 1030, Wichita, Kansas
Character of Well (completed as Oil, Gas or Dry Hole) Dry Hole
Date well completed Mar. 23, 1954
Application for plugging filed March 23, 1954
Application for plugging approved March 23, 1954
Plugging commenced March 23, 1954
Plugging completed March 23, 1954
Reason for abandonment of well or producing formation Dry Hole

NORTH

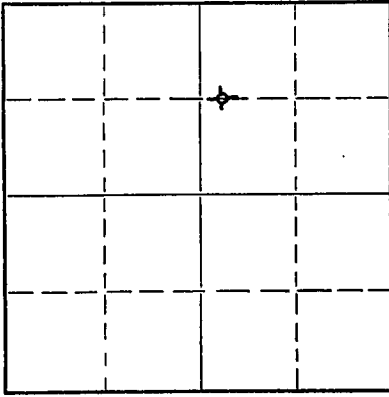

Locate well correctly on above Section Plat

If a producing well is abandoned, date of last production _____ 19____
Was permission obtained from the Conservation Division or its agents before plugging was commenced? Yes

Name of Conservation Agent who supervised plugging of this well Eldon Petty
Producing formation _____ Depth to top _____ Bottom _____ Total Depth of Well 3781 Feet
Show depth and thickness of all water, oil and gas formations.

OIL, GAS OR WATER RECORDS

CASING RECORD

FORMATION	CONTENT	FROM	TO	SIZE	PUT IN	PULLED OUT
		0	210	8 5/8"	210	None

Describe in detail the manner in which the well was plugged, indicating where the mud fluid was placed and the method or methods used in introducing it into the hole. If cement or other plugs were used, state the character of same and depth placed, from _____ feet to _____ feet for each plug set.

From 3781' to 201 1/2' - heavy rotary mud
 201 1/2' to 200' - wooden plug
 200' to 154' - 15 sacks cement & 1/2 sack hulls
 154' to 41 1/2' - heavy rotary mud
 41 1/2' to 40' - wooden plug
 40' to 6' - 10 sacks cement & 1/2 sack hulls
 6' to surface - cellar

(If additional description is necessary, use BACK of this sheet)

Name of Plugging Contractor Glenn W. Peel
Address P.O. Box 359, Hoisington, Kansas

STATE OF KANSAS, COUNTY OF BARTON, ss.
Glenn W. Peel (employee of owner) or (owner or operator) of the above-described well, being first duly sworn on oath, says: That I have knowledge of the facts, statements, and matters herein contained and the log of the above-described well as filed and that the same are true and correct. So help me God. GLENN W. PEEL

(Signature) BY: *Manion M. Herbert*
P.O. Box 359, Hoisington, Kansas (Address)

SUBSCRIBED AND SWORN TO before me this 25th day of March, 1954

Manion M. Herbert
Notary Public.

My commission expires June 4, 1955

24-7368-6 3-53-20M

PLUGGING
FILE SEC 27 T 10 S 20 W
BOOK PAGE 22 LINE 24

04-01-54

DRILLERS' LOG

Company: The Derby Oil Company

C W/2 W/2 NE/4

Farm Name: Annon

Well No. 2

Sec. 27, Rge. 10S, Rge. 20W,

Total Depth: 3781'

County: Rocks,
Kansas

Comm: 3-13-54 Comp: 3-23-54

Contractor: Glenn W. Peel

Elevation:

Casing: 8 5/8" 210' dem.

Production: Dry

Figures below indicate bottoms of formations:

Sand and shale	0 -	212
Shale		670
Sand		810
Shale		1000
Shale and sand		1610
Anhydrite		1645
Shale		1660
Shale and shells		2075
Shale and Lime		3290
Lime		3620
Lime and chert		3695
Lime		3730
Conglomerate		3755
Shale		3773
Lime		3781
Total Depth		3781

This is to certify that the above information is to the best of our knowledge, true and correct.

GLENN W. PEEL

BY: *Glenn W. Peel*

SUBSCRIBED AND SWORN to before me this 25th day of March, 1954.

My commission expires: June 4, 1955

Marion M. Herbst
Notary Public

PLUGGING
SEC 27 T10 R20W
RGE 22 L1S 24