


STATE OF KANSAS
STATE CORPORATION COMMISSION

WELL PLUGGING RECORD

Give All Information Completely
Make Required Affidavit
Mail or Deliver Report to
Conservation Division
State Corporation Comm.
245 North Water
Wichita, KS 67202

Rooks County, Sec. 27 Twp. 10S Rge. 20 E/W
Location as "NE/CNW $\frac{1}{4}$ SW $\frac{1}{4}$ " or footage from lines
Coastal Oil & Gas Corporation

Lease Owner
Lease Name Williams Well No. 6
Office Address Coastal Tower-Nine Greenway Plaza Houston, TX
Character of Well (Completed as Oil, Gas or Dry Hole)
Dry Hole

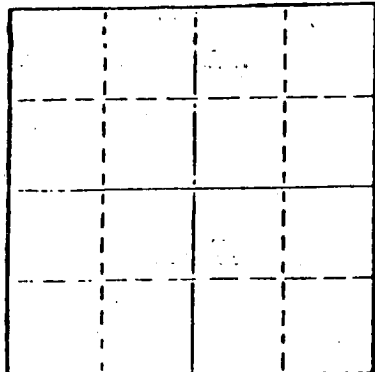

Locate well correctly on above
Section Plat

Date Well completed 5-17-80 19
Application for plugging filed 5-17-80 19
Application for plugging approved 5-17-80 19
Plugging commenced 5-17-80 19
Plugging completed 5-17-80 19
Reason for abandonment of well or producing formation
Dry Hole

If a producing well is abandoned, date of last production
19

Was permission obtained from the Conservation Division or
its agents before plugging was commenced?

Name of Conservation Agent who supervised plugging of this well
Producing formation Depth to top Bottom Total Depth of Well
Show depth and thickness of all water, oil and gas formations.

OIL, GAS OR WATER RECORDS

CASING RECORD


FORMATION	CONTENT	FROM	TO	SIZE	PUT IN	PULLED OUT

Describe in detail the manner in which the well was plugged, indicating where the mud fluid
was placed and the method or methods used in introducing it into the hold. If cement or other
plugs were used, state the character of same and depth placed, from feet to
feet for each plug set.

1st Plug @ 900' w/60 sks
2nd Plug @ 340' w/30 sks
3rd Plug @ 40' w/Solid Bridge
& 10 sks - 5 sks in Rat Hole

(If additional description is necessary, use BACK of this sheet)

Name of Plugging Contractor Gabbert-Jones, Inc.

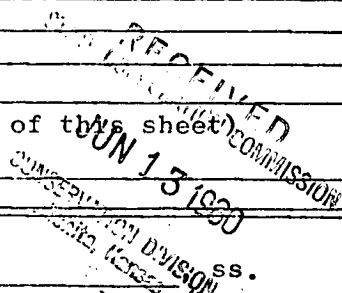

STATE OF Kansas COUNTY OF Sedgwick
Jack W. Gabbert (employee of owner) or (owner or operator)
of the above-described well, being first duly sworn on oath, says: That I have knowledge of
the facts, statements, and matters herein contained and the log of the above-described well
as filed and that the same are true and correct. So help me God.

(Signature)

830 Sutton Place - Wichita, Ks. 67202
(Address)

SUBSCRIBED AND SWORN TO before me this 12th day of June, 1980

Elizabeth J. Edwards
Notary Public.

My commission expires February 6, 1983



15-163-21051-0000

GABBERT-JONES, INC.
WICHITA, KANSAS
DRILLERS' WELL LOG

Williams #6
NW-SE-NW Sec 27-10S-20W
Rooks County Kansas

Commenced: 5-8-80

Completed: 5-17-80

OPERATOR: Coastal Oil & Gas Corporation

Depth		Formation	Remarks
From	To		
0	342	Blue Shale-Sand	Ran 9 jts of 24# 8 5/8" csg
342	1070	Sand-Shale	set @ 342' w/Texas Pattern
1070	1250	Sand	Shoe - Centerlizer @ 332'
1250	1565	Shale-Shells	Insert Float @ 301'
1565	1608	Anhy	Cemented w/225 sks Class A
1608	2142	Shale-Shells	2% Gel - 2% CC
2142	3700	Lime-Shale	PD @ 3:15 p.m. 5-8-80
3700	3960	Lime	
	3960 - TD		DRY & ABANDONED

STATE OF KANSAS)
) SS
COUNTY OF SEDGWICK)

I, the undersigned, being duly sworn on oath, state that the above Drillers' Well Log is true and correct to the best of my knowledge and belief and according to the records of this office.

GABBERT-JONES, INC.

James S. Sutton II
JAMES S. SUTTON II

Subscribed and sworn to before me this 27th day of May, 1980.

Elizabeth J. Edwards
ELIZABETH J. EDWARDS-NOTARY PUBLIC

My Commission expires February 6, 1983.

