


STATE OF KANSAS
STATE CORPORATION COMMISSION

WELL PLUGGING RECORD

Give All Information Completely
Make Required Affidavit
Mail or Deliver Report to:
Conservation Division
State Corporation Commission
212 North Market, Insurance Bldg.
Wichita, Kansas

Rooks County. Sec. 27 Twp. 10 Rge. 20 (E) W (W)
Location as "NE/CNW/SW" or footage from lines N 1/2 NW 8 1/2
Lease Owner I.O. Miller
Lease Name Towns Well No. 2
Office Address 619 Brown Bldg. Wichita, Ke.
Character of Well (completed as Oil, Gas or Dry Hole) Oil
Date well completed Dec. 11, 19 55
Application for plugging filed July 10, 19 61
Application for plugging approved July 12, 19 61
Plugging commenced July 12, 19 61
Plugging completed July 15, 19 61
Reason for abandonment of well or producing formation Oil Depleted

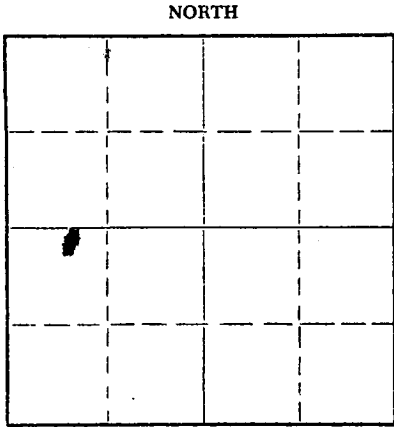

Locate well correctly on above
Section Plat

If a producing well is abandoned, date of last production July 1, 19 61
Was permission obtained from the Conservation Division or its agents before plugging was commenced? Yes

Name of Conservation Agent who supervised plugging of this well Eldon Petty
Producing formation Arbuckle Depth to top 3664' Bottom 3576' Total Depth of Well 3679' Feet
Show depth and thickness of all water, oil and gas formations.

OIL, GAS OR WATER RECORDS

CASING RECORD

FORMATION	CONTENT	FROM	TO	SIZE	PUT IN	PULLED OUT
				8 5/8	230'	none
				5 1/2	3676'	3274

Describe in detail the manner in which the well was plugged, indicating where the mud fluid was placed and the method or methods used in introducing it into the hole. If cement or other plugs were used, state the character of same and depth placed, from _____ feet to _____ feet for each plug set.

~~XXXXXXXXXXXXXXXXXXXX~~
Plugged back with sand from 3515' to 3400'. Mixed and dumped 5 ex. cement from 3400' to 3360'. Pulled casing to 550'. Mixed and circulated 20 ex. gel mud. Mixed and pumped in 20 ex. cement from 550' to 490'. Pulled casing to 250'. Mixed and pumped in 20 ex. cement from 250' to 190'. Pulled rest casing. Bailed off gel to 35'. Set 5' rock bridge from 35' to 30'. Mixed and dumped 10 ex. cement from 30' to base cellar.

RECEIVED
STATE CORPORATION COMMISSION
JUL 31 1961
CONSERVATION DIVISION
Wichita, Kansas

(If additional description is necessary, use BACK of this sheet)
Name of Plugging Contractor ACE PIPE PULLING CO.
Address Box 304 Great Bend, Ke.

STATE OF _____, COUNTY OF _____, ss. _____ (employee of owner) or (owner or operator) of the above-described well, being first duly sworn on oath, says: That I have knowledge of the facts, statements, and matters herein contained and the log of the above-described well as filed and that the same are true and correct. So help me God.

(Signature) James O. Lusk
James O. Lusk
(Address)

SUBSCRIBED AND SWORN TO before me this 20th day of July, 19 61

My commission expires December 4, 1962 Arnold Leminger Notary Public.



Drilling log of formations

L.O. Miller Oil Co.
619 Brown Bldg.
Wichita, Ks.

Towns #2
NE NW SW
27-10s-20w

Depth	Sample
3300'-3350'	Lime-Shale-Sand
3350'-3420'	Shale-Lime
3420'-3430'	Shale
3430'-3500'	Sand-Lime-Shale
3500'-3530'	Lime-Shale
3530'-3550'	Lime-Sand
3550'-3590'	Lime-Shale
3590'-3630'	Shale-Lime-Sand
3630'-3669'	Shale
3669'-3676'	Shale-Sand

RECEIVED
 STATE CORPORATION COMMISSION
 JUL 24 1961
 CONSERVATION DIVISION
 WICHITA, KANSAS

The above facts are true to the best of my knowledge.

James D. Tubbs

Subscribed and sworn to before me this 20th day of July 1961.

Arnold Linniger

 Notary Public.

My commission expires December 4, 1962