

15-163-20539-0000


STATE OF KANSAS
STATE CORPORATION COMMISSION
CONSERVATION DIVISION
P. O. BOX 17027
WICHITA, KANSAS 67217

FORM CP-4

WELL PLUGGING RECORD

Rooks County, Sec. 27 Twp. 10 Rge. 20 (E) (W)

NORTH

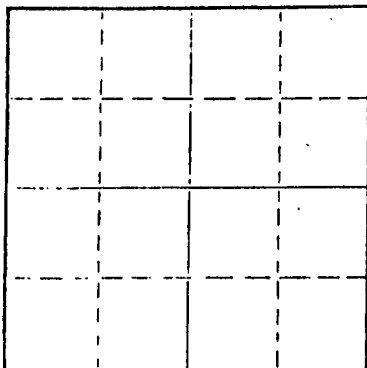

Locate well correctly on above Section Plat

Location as "NE/CNW&SW&SE" or footage from lines NW SE NE
Lease Owner Calvin Noah
Lease Name Sutor-Annon #2 Well No.
Office Address Valley Center, Kansas 67147
Character of Well (completed as Oil, Gas or Dry Hole)
Date well completed 19
Application for plugging filed 19
Application for plugging approved 19
Plugging commenced 8/2/76 19
Plugging completed 8/4/76 19
Reason for abandonment of well or producing formation depleted.

If a producing well is abandoned, date of last production 19
Was permission obtained from the Conservation Division or its agents before plugging was commenced? yes

Name of Conservation Agent who supervised plugging of this well Massey
Producing formation Depth to top Bottom Total Depth of Well 3738 Feet
Show depth and thickness of all water, oil and gas formations.

OIL, GAS OR WATER RECORDS

CASING RECORD

FORMATION	CONTENT	FROM	TO	SIZE	PUT IN	PULLED OUT
				8-5/8	207	none
				5 1/2"	3734	3054

Describe in detail the manner in which the well was plugged, indicating where the mud fluid was placed and the method or methods used in introducing it into the hole. If cement or other plugs were used, state the character of same and depth placed, from feet to feet for each plug set.

Ran sand to 3700' and ran 4 sacks cement. Shot pipe at 3040' and pulled 99 joints. Squeezed well with 3 sacks hulls, 20 sacks gel and 70 sacks cement, 10 sacks gel, released plug and displaced with 50 sacks cement.

PLUGGING COMPLETE.

RECEIVED
STATE CORPORATION COMMISSION

AUG 13 1976

Name of Plugging Contractor (If additional description is necessary, use BACK of this sheet) KELSO CASING PULLING
Address CHASE, KANSAS
CONSERVATION DIVISION
Wichita, Kansas

STATE OF KANSAS COUNTY OF RICE
R. DARRELL KELSO (employee of owner) or (owner or operator) of the above-described

well, being first duly sworn on oath, says: That I have knowledge of the facts, statements, and matters herein contained and the log of the above-described well as filed and that the same are true and correct. So help me God.

(Signature) R. Darrell Kelso
CHASE, KANSAS (Address)

SUBSCRIBED AND SWORN TO before me this 11th day of August 1976

My commission expires
NOTARY PUBLIC
MARGARET MELCHER
Rice County, Ks.
My Comm. Exp. Feb. 15, 1979
KANSAS

Margaret Melcher
Notary Public.

CONTRACTOR'S WELL LOG

elev. 2155 GL.

OPERATOR:	Calvin Noah
CONTRACTOR:	Abercrombie Drilling, Inc.
WELL NAME:	SUTOR-ANNON #2
LOCATION:	C NW SE NE Sec. 27-10S-20W
	<i>Rooks</i> Graham County, Kansas
GEOLOGIST:	Gerald Becker
SPUD DATE:	August 31, 1974
COMPLETION DATE:	September 10, 1974

0	90	Rock & Sand
90	125	Sand & Clay
125	207	Shale
207	690	Clay & Shale
690	885	Sand
885	1090	Shale
1090	1330	Sand
1330	1613	Shale
1613	1652	Anhydrite
1652	2090	Sand & Shale
2090	3101	Shale & Lime
3101	3409	Lime & Shale
3409	3738	Lime
	3738	Rotary Total Depth

Drilled 207' of 12 1/2" hole. Set 5 jts. 8 5/8" at 201.80'. Cemented with 150 sacks cement, cement circulated. Plug was down @9:00 p.m., 8-31-74.

14# Ran 121 jts. Used 5 1/2". Set @3734.5' with 100 sacks 60-40 Posmix, 18% salt, 2% gel, 3/4 of 1% CFR2. Plug was down @9:10 p.m., 9-10-74.

STATE OF KANSAS)
) SS
 COUNTY OF SEDGWICK)

Jack K. Wharton of Abercrombie Drilling, Inc., does hereby state that the above and foregoing is a true and correct copy of the log of the SUTOR-ANNON #2, C NW SE NE Section 27-10S-20W, Graham County, Kansas.

ABERCROMBIE DRILLING, INC.

By: *Jack K. Wharton*
 Jack K. Wharton-Geologist

Subscribed and sworn to before me, a Notary Public, in and for the aforesaid county and state as of this 13th day of September, 1974.

Nancy E. Bledsoe
 Nancy E. Bledsoe-Notary Public

My Commission Expires:

April 8, 1978

