

WELL PLUGGING RECORD

Give All Information Completely
Make Required Affidavit
Mail or Deliver Report to
Conservation Division
State Corporation Comm.
200 Colorado Derby Bldg.
202 W. 1st St.
Wichita, KS 67202

Rooks County Sec. 27 Twp. 10s Rge. 20 E, W
Location as "NE/CNW/SW" or footage from lines

NE NE SW

Lease Owner Bowman Oil Company Lic 6931

Lease Name Towns Well No. #1

Office Address 308 West Mill Plainville, Ks 67663

Character of Well (Completed as Oil, Gas or Dry Hole) Dry Hole

Date Well completed 10-24 1982

Application for plugging filed 10-24 1982

Application for plugging approved 10-24 1982

Plugging commenced 10-24 1982

Plugging completed 10-24 1982

Reason for abandonment of well or producing formation No Commercial Production


If a producing well is abandoned, date of last production 19

Was permission obtained from the Conservation Division or its agents before plugging was commenced? Yes

Name of Conservation Agent who supervised plugging of this well Marion Schmidt

Producing formation Depth to top Bottom Tl. Depth of Well

Show depth and thickness of all water, oil and gas formations.

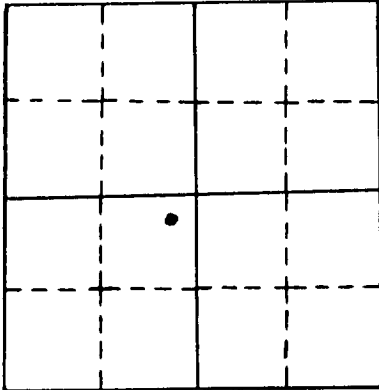

locate well correctly
on above
Section Plot

OIL, GAS OR WATER RECORDS

CASING RECORD

FORMATION	CONTENT	FROM	TO	SIZE	PUT IN	PULLED OUT
Surface Casing	60-40poz	0'	260.37'	8 5/8"	260.37'	0'

Describe in detail the manner in which the well was plugged, indicating where the mud fluid was placed and the method or methods used in introducing it into the hold. If cement or other plugs were used, state the character of same and depth placed, from feet to feet for each plug set.

- Plug #1 3750' with 20sxs
 - Plug #2 1625' with 20sxs
 - Plug #3 850' with 100sxs
 - Plug #4 300' with 40sxs
 - Plug #5 40' with 10sxs
- 10sxs in rathole

RECEIVED
STATE CORPORATION COMMISSION
DEC 10 1982
CONSERVATION DIVISION
Wichita, Kansas

(P.D. @ 3:30 P.M. 10-24-82) Total-----200sxs 50-50poz 6%gel 3%cc


(If additional description is necessary, use BACK of this sheet)

Name of Plugging Contractor PIONEER DRILLING COMPANY
308 WEST MILL PLAINVILLE, KS 67663

STATE OF Kansas COUNTY OF Rooks, ss.

Louis D. Bowman (employee of owner) or (owner or operator) of the above described well, being first duly sworn on oath, says: That I have knowledge of the facts, statements, and matters herein contained and the log of the above described well is filed and that the same are true and correct. So help me God.

(Signature) Louis D. Bowman
(Address) Box 17 Code 11, Ks 67630

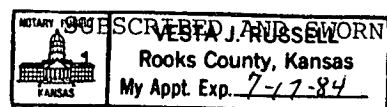

TO before me this 9th day of December, 1982

Vesta J. Russell
Notary Public

My commission expires July 17, 1984