


Give All Information Completely
 Make Required Affidavit
 Mail or Deliver Report to:
 Conservation Division
 State Corporation Commission
 800 Bitting Building
 Wichita, Kansas

OR
FORMATION PLUGGING RECORD

Strike out upper line
 when reporting plug-
 ging off formations.

~~XXXX~~ Rooks County. Sec. 27 Twp. 10 Rge. 20 ~~XE~~ W (W)
 Location as "NE $\frac{1}{4}$ NW $\frac{1}{4}$ SW $\frac{1}{4}$ " or footage from lines SE $\frac{1}{2}$ SE $\frac{1}{2}$ SE $\frac{1}{2}$
 Lease Owner Nate Appleman Company
 Lease Name Pogue Well No. 1
 Office Address Wichita, Kansas.
 Character of Well (completed as Oil, Gas or Dry Hole) Dry Hole
 Date well completed June 21st 1944
 Application for plugging filed June 21st 1944
 Application for plugging approved June 21st 1944
 Plugging commenced June 21st 1944
 Plugging completed June 21st 1944
 Reason for abandonment of well or producing formation Dry Hole

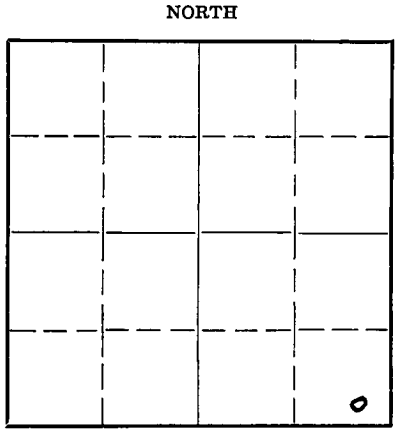

Locate well correctly on above
 Section Plat

If a producing well is abandoned, date of last production 19
 Was permission obtained from the Conservation Division or its agents before plugging was com-
 menced? Yes

Name of Conservation Agent who supervised plugging of this well Eldon R. Petty
 Producing formation Depth to top Bottom Total Depth of Well 3820 Feet
 Show depth and thickness of all water, oil and gas formations.

OIL, GAS OR WATER RECORDS				CASING RECORD		
Formation	Content	From	To	Size	Put In	Pulled Out
Sand	25' Water	25'	160'	10 3/4"	245'	None

Describe in detail the manner in which the well was plugged, indicating where the mud fluid was placed and the method or methods used in introducing it into the hold. If cement or other plugs were used, state the character of same and depth placed, from feet to feet for each plug set.
Hole plugged with heavy mud from 3820 to 245', permanent plug placed at 245'
and cemented with 15 sacks of cement, from 245' to 215'
Heavy Mud to 26' then permanent plug enstalled and cemented with 10 sacks
of cement from 26' to 6'

FILED 27 10 20 20
300 121 30

(If additional description is necessary, use BACK of this sheet)
 Correspondence regarding this well should be addressed to Nate Appleman Company
 Address Wichita, Kansas.

STATE OF Kansas, COUNTY OF Sedgwick, ss.
Jim Adkins (employee of owner) or (owner or operator) of the above-described well,
 being first duly sworn on oath, says: That I have knowledge of the facts, statements, and matters herein contained and the log of the above-
 described well as filed and that the same are true and correct. So help me God.

(Signature) Jim Adkins
1502-12th St., Great Bend, Kansas.
 (Address)

SUBSCRIBED AND SWORN to before me this 13 day of July, 1944
Ethel Mae Clinton
 Notary Public.

My commission expires 10-2-44

07-14-44

15-163-00083-0000

N. AMERICAN COMPANY'S
 DEWELL #1

Southeast Corner of Section 21, Township 19 South
 Range 20 West, Rocks County, Kansas

Ran 7 joints, 260' of 10 3/4 O. D. Spiral Weld casing, set at 245' with 125 sacks cement.
 Plugged hole with 15 sacks cement at bottom plug from 250' to 210' top plug with
 10 sacks from 25' to bottom of cellar.

Digging up rotary tools 5-21-44
 Tearing out tools 6-22-44

<u>FORMATION</u>	<u>FROM</u>	<u>TO</u>	<u>REMARKS</u>
Surface dirt & sand rock	0	25	
Sand Rock	25	100	
Stickey clay & sand Rock	100	245	
	245	255	
Shale & Shale	255	299	
Shale & Shells	299	1015	
Sand & Shale	1015	1350	
Shale & Shells	1350	1525	Slope Test 1250 O.K.
Sand	1525	1581	Slope Test 1500 O.K.
Shale & Shells	1581	1600	
Red bed & Shale	1600	1690	
Lime shells & Shale	1690	1750	
Shale & Shells	1750	1860	Slope Test 1750 O.K.
Shale Lime & Shale	1860	1970	
Shale & Shells	1970	2090	
Shale & Shells	2090	2250	
Lime shells & Shale	2250	2325	
Lime & Shale	2325	2375	
Shale & lime shells	2375	2510	
Lime & Shale	2510	2550	
Lime & Shale	2550	2625	
Shale	2625	2645	Slope Test 2550 O.K.
Sandy Shale	2645	2670	
	2670	2687	S. L. Correction
Lime	2687	2675	
Lime & Shale	2675	2735	
Lime & Shale	2735	2775	
Shale & Shells	2775	2850	
Shale	2850	2890	
Shale & Shells	2890	2970	
Shale	2970	2981	
Lime	2981	2985	
Lime	2985	3025	
Lime & Shale	3025	3055	
Broken Lime	3055	3080	
Shale & Lime	3080	3125	
Sand No Order	3125	3142	
Broken Lime & Shale	3142	3190	
Broken Lime	3190	3240	
Lime	3240	3280	
Lime	3280	3295	
Lime	3295	3445	
Cherty Lime	3445	3465	
Lime	3465	3500	

SHALPLUGGING
 FILE 27 10-208142
 BOOK PAGE 21 LINE 28



15-163-00083-0000

H. APPLEMAN COMPANY'S
LOG #1

Southeast Corner of Section 21, Township 10 South,
Range 20 West, Rocks County, Kansas

Line	3500	3535	
Line	3535	3590	
Conglomerate	3590	3710	
Cherty Lime	3710	3722	
Coars Cherty Lime	3722	3825	
Chert Very Rough	3725	3725	
	3725	3730	
Chert	3730	3741	
Lime Rough	3741	3762	
	3762	3765	
Arbuckle Lime	3785	3815	
Lime	3815	3820	Total Depth

I, W. A. Grant, partner of the Harbor Drilling Company, certify that to the best of my knowledge and belief, the above log is true and correct.

W. A. Grant

Subscribed and sworn to before me this 13 day of July, 1944.

Ethel Mae Clintan
Notary Public

My commission expires 10/2/44

PLUGGING
FILE 27 10-200
BOOK PAGE 2/LINE 30