


WELL PLUGGING RECORD

Give All Information Completely
Make Required Affidavit
Mail or Deliver Report to:
Conservation Division
State Corporation Commission
800 Blitting Building
Wichita, Kansas

NORTH

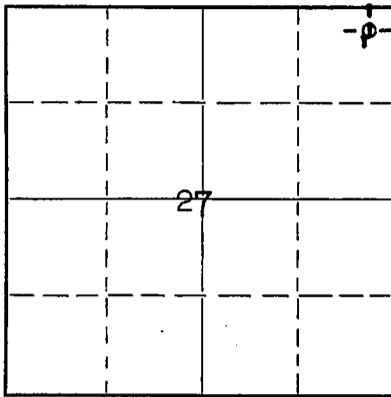

Locate well correctly on above
Section Plat

Rooks County. Sec. 27 Twp. 10 Rge. 20 (E) W (W)
Location as "NE/CNW $\frac{1}{4}$ /SW $\frac{1}{4}$ " or footage from lines... NE Corner
Lease Owner Gulf and Nadel and Gussman
Lease Name Annon Well No. 1
Office Address 703 Union National Bank Bldg. Wichita, Kansas
Character of Well (completed as Oil, Gas or Dry Hole) Dry
Date well completed 6-2 19 50
Application for plugging filed 6-2 19 50
Application for plugging approved 6-2 19 50
Plugging commenced 6-2 19 50
Plugging completed 6-2 19 50
Reason for abandonment of well or producing formation Dry

If a producing well is abandoned, date of last production 19
Was permission obtained from the Conservation Division or its agents before plugging was commenced? Yes

Name of Conservation Agent who supervised plugging of this well Mr. Pettie
Producing formation Depth to top Bottom Total Depth of Well 3760 Feet
Show depth and thickness of all water, oil and gas formations.

OIL, GAS OR WATER RECORDS

CASING RECORD

Formation	Content	From	To	Size	Put In	Pulled Out
				8-5/8	160'	None

Describe in detail the manner in which the well was plugged, indicating where the mud fluid was placed and the method or methods used in introducing it into the hole. If cement or other plugs were used, state the character of same and depth placed, from feet to feet for each plug set.

Pits jetted until mud very heavy and then hole filled with heavy mud from 3760 to 155' where plug and 15 sacks cement were set in plug at 35' with 10 sacks cement

06-09-50

(If additional description is necessary, use BACK of this sheet)

Correspondence regarding this well should be addressed to Nadel and Gussman
Address P. O. Drawer 309, Tulsa, Oklahoma

STATE OF KANSAS, COUNTY OF SEDGWICK, ss.

L. C. Hay (employee of owner) or (owner or operator) of the above-described well, being first duly sworn on oath, says: That I have knowledge of the facts, statements, and matters herein contained and the log of the above-described well as filed and that the same are true and correct. So help me God.

(Signature)

L. C. Hay


703 Union National Bank Bldg.
(Address)

SUBSCRIBED AND SWORN to before me this 6th day of June, 1950

Paul B. ...

Notary Public.

My commission expires Nov. 3, 1952

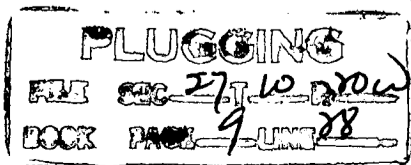

15-163-00397-0000x

WELL LOG

Nadel and Gussman

ANNON No. 1

330' So. 330' W NEc
Section 27-10S-20W
Rooks County, Kansas

Comm. 5-31-50
Comp. 6- 2-50

Casing: 8-5/8" 160' w/125 Sax

Formations	Depth
Shale and Sand	160
Shale	700
Shale and Sand	1010
Shale and shells	1095
Sand	1285
Shale, Shells, Red Bed	1605
Anhydrite	1650
Shale and Red Beds	1950
Shale and Shells	2170
Broken Lime	2210
Shale and Lime	2840
Shale and Shells	2935
Shale and lime	3256
Broken Lime	3316
Lime and shale	3430
Lime	3528
Lime-Shale	3567
Lime	3671
Conglomerate	3712
Shale	3728
Arbuckle Lime	3750
T.D.	3760

TOPS

Toneka	3184
Heebner Shale	3392
Dodge	3413
Lansing-K.C.	3431
Basal Penn.	
Conglomerate	3671
Simpson	3716
Arbuckle	3728

STATE OF KANSAS)
 SS:
COUNTY OF SEDGWICK)

L. C. Hay, of lawful age, being first duly sworn, deposes and says that the above formations and depths are correct according to the daily drilling log of the No. 1 Annon in the NE Corner of Sec. 27-10 South, 20 West, Rooks County, Kansas.

L. C. Hay

Subscribed and sworn to before me this 6th day of June, 1950.

John B. Bady
Notary Public

My commission expires Nov. 3, 1952

