


WELL PLUGGING RECORD

Give All Information Completely  
Make Required Affidavit  
Mail or Deliver Report to:  
Conservation Division  
State Corporation Commission  
800 Bittling Building  
Wichita, Kansas

NORTH

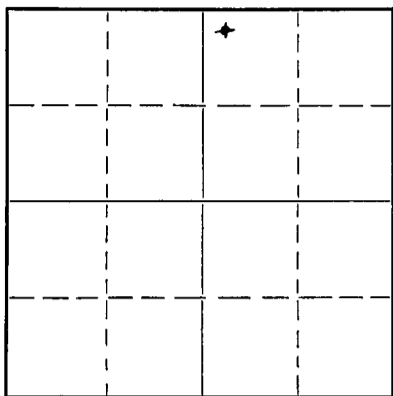

Locate well correctly on above Section Plat

Rooks County. Sec. 29 Twp. 10S. Rge. 17 20 (W)  
Location as "NE/CNW $\frac{1}{4}$ SW $\frac{1}{4}$ " or footage from lines NW/4 NW/4 NE/4  
Lease Owner Sunray Oil Corporation  
Lease Name Metheny Well No. 1  
Office Address Box 195, Great Bend, Kansas  
Character of Well (completed as Oil, Gas or Dry Hole) Dry Hole  
Date well completed June 6 1951  
Application for plugging filed June 11 1951  
Application for plugging approved June 6 1951  
Plugging commenced June 6 1951  
Plugging completed June 6 1951  
Reason for abandonment of well or producing formation Dry Hole

If a producing well is abandoned, date of last production 19  
Was permission obtained from the Conservation Division or its agents before plugging was commenced? Yes

Name of Conservation Agent who supervised plugging of this well Eldon Petty  
Producing formation None Depth to top Bottom Total Depth of Well 3913 Feet  
Show depth and thickness of all water, oil and gas formations.

OIL, GAS OR WATER RECORDS

CASING RECORD

Formation	Content	From	To	Size	Put In	Pulled Out
Lansing-KC	Water	3482	3705	8-5/8"	1682	None
Conglomerate	Water	3744	3913			

Describe in detail the manner in which the well was plugged, indicating where the mud fluid was placed and the method or methods used in introducing it into the hole. If cement or other plugs were used, state the character of same and depth placed, from feet to feet for each plug set.

Cement plugs spotted through drill pipe as follows:

40 sax from 240' to 120'  
10 sax from 40' to 10'

RECEIVED  
STATE CORPORATION COMMISSION  
JUN 20 1951  
CONSERVATION DIVISION  
Wichita, Kansas

(If additional description is necessary, use BACK of this sheet)


Correspondence regarding this well should be addressed to Sunray Oil Corporation  
Address Box 195, Great Bend, Kansas

STATE OF KANSAS, COUNTY OF BARTON, ss.  
R. C. McMahan (employee of owner) of the above-described well,  
being first duly sworn on oath, says: That I have knowledge of the facts, statements, and matters herein contained and the log of the above-described well as filed and that the same are true and correct. So help me God.  
(Signature) R.C. McMahan Engineer  
Box 195, Great Bend, Kansas (Address)

SUBSCRIBED AND SWORN to before me this 19th day of June 19 51

Martha Scott Notary Public.

My commission expires April 19, 1952.

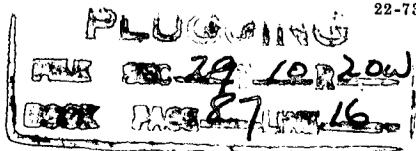

Tulsa, Oklahoma  
June 8, 1951

Sunray Oil Corporation  
Tulsa, Oklahoma

CONTRACTOR: STIC LE DRILLING COMPANY  
Drilling Commenced: May 22, 1951  
Drilling Completed: June 6, 1951

Ethel Metheny #1 NE $\frac{1}{4}$  of Section 29-10S-20W, Rooks County, Kansas

DRILLERS LOG

Sand	0-40
Shale & Shells	40-550
Sand	550-670
Shale	670-740
Sand	740-780
Shale & Shells	780-1155
Sand	1155-1175
Shale & Shells	1175-1435
Red Bed	1435-1674
Anhydrite	1674-1730
Shale	1730-2215
Lime & Shale	2215-2295
Shale & Lime	2295-2565
Lime	2565-2630
Shale	2630-2700
Shale & Lime	2700-2795
Shale	2795-2895
Shale & Shells	2895-2980
Shale & Lime	2980-3152
Shale	3152-3226
Lime & Shale	3226-3336
Lime	3336-3808
Conglomerate	3808-3913 TD.

I, Frank W. Stickle, hereby certify the above to be a true and complete drillers log of Sunray Oil Corporation's Ethel Metheny #1-NE $\frac{1}{4}$  of Section 29-10S-20W, Rooks County, Kansas.

Frank W. Stickle  
Frank W. Stickle

Lillian T. Bonham  
Notary Public

February 13, 1952  
My commission expires

**PLUGGING**  
WELL NO. 29-10-20W  
PAGE 87 LINE 16