

TYPE

AFFIDAVIT OF COMPLETION FORM

ACO-1 WELL HISTORY

Compt. _____

SIDE ONE

Two (2) copies of this form shall be filed with the Kansas Corporation Commission, 200 Colorado Derby Building, Wichita, Kansas 67202, within thirty (30) days after the completion of a well, regardless of how the well was completed.

F Attach separate letter of request if the information is to be held confidential. If confidential, only file one copy. Information on Side One will be of public record and Side Two will then be held confidential.

Applications must be made on dual completion, commingling, salt water disposal, injection and temporarily abandoned wells.

C Attach one copy only wireline logs (i.e. electrical log, sonic log, gamma ray neutron log, etc.). (Rules 82-2-105 & 82-2-125) KCC# (316) 263-3238.

LICENSE # 5616 EXPIRATION DATE 6-30-1983

OPERATOR Calvin Noah API NO. 15-163-21,912-00-00

ADDRESS 329 N. Birch COUNTY Rooks

Valley Center, KS 67147 FIELD Trico

** CONTACT PERSON Calvin Noah PROD. FORMATION Lansing-KC.

PHONE 316-755-1032

PURCHASER Mobil Oil Corp. LEASE SUTOR-ANNON

ADDRESS P.O. Box 900, Dallas, Texas WELL NO. 6

75221 WELL LOCATION 50' N of SW SW NE

DRILLING Abercrombie Drilling, Inc. 330 Ft. from West Line and


CONTRACTOR ADDRESS 801 Union Center 380 Ft. from South Line of (E)

Wichita, KS 67202 the NE (Qtr.) SEC 27 TWP 10SRGE 20W(W).

PLUGGING CONTRACTOR ADDRESS

WELL PLAT

(Office Use Only)

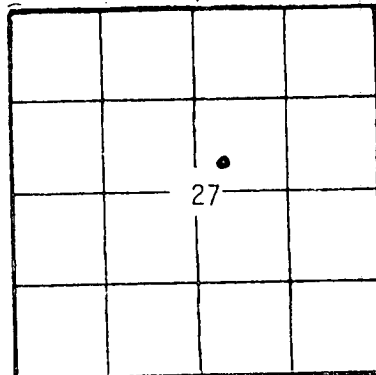

KCC [checked] KGS [checked] SWD/REP PLG.

TOTAL DEPTH 3785' PBDT 3664

SPUD DATE 12/15/82 DATE COMPLETED 2-15-1983

ELEV: GR 2146' DF 2149' KB 2151'

DRILLED WITH (CABLE) (ROTARY) (AIR) TOOLS.

DOCKET NO. OF DISPOSAL OR REPRESSURING WELL BEING USED TO DISPOSE OF WATER FROM THIS LEASE C-15,921.

Amount of surface pipe set and cemented 235.46' (91,045-C) DV Tool Used? Yes, Port Collar Cement circulated

THIS AFFIDAVIT APPLIES TO: (Circle ONE) -(Oil) Gas, Shut-in Gas, Dry, Disposal, Injection, Temporarily Abandoned, OWWO. Other

ALL REQUIREMENTS OF THE STATUTES, RULES AND REGULATIONS PROMULGATED TO REGULATE THE OIL AND GAS INDUSTRY HAVE BEEN FULLY COMPLIED WITH.


A F F I D A V I T

Calvin Noah, being of lawful age, hereby certifies that:

I am the Affiant, and I am familiar with the contents of the foregoing Affidavit. The statements and allegations contained therein are true and correct.

Calvin Noah (Name)

SUBSCRIBED AND SWORN TO BEFORE ME this 21st day of March, 1983.

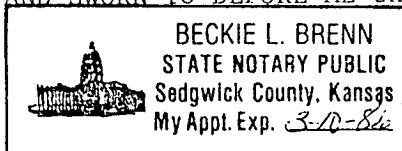

Beckie L. Brenn (NOTARY PUBLIC)

MY COMMISSION EXPIRES: March 10, 1984

** The person who can be reached by phone regarding any questions concerning this information.

RECEIVED STATE CORPORATION COMMISSION

MAR 22 1983

CONSERVATION DIVISION Wichita, Kansas