

WELL PLUGGING RECORD

Give All Information Completely  
Make Required Affidavit  
Mail or Deliver Report to:  
Conservation Division  
State Corporation Commission  
212 No. Market  
Wichita, Kansas

Trego County, Sec. 29 Twp. 12S Rge. 21 (E) W (W)

Location as "NE/CNW/SW" or footage from lines. C S/2 NW/4 NE/4

Lease Owner ~~Blakely~~ Clinton Oil Company

Lease Name Blakely Well No. 1-X

Office Address Wichita, Kansas - 6810 W. Highway U.S. 54

Character of Well (completed as Oil, Gas or Dry Hole) Dry Hole

Date well completed December 8 1965

Application for plugging filed December 23 1965

Application for plugging approved December 27 1965

Plugging commenced 12-28-65 19


Plugging completed 12-30-65 19

Reason for abandonment of well or producing formation Depleted. Water

encroachment

If a producing well is abandoned, date of last production July 30 1965

Was permission obtained from the Conservation Division or its agents before plugging was commenced? yes

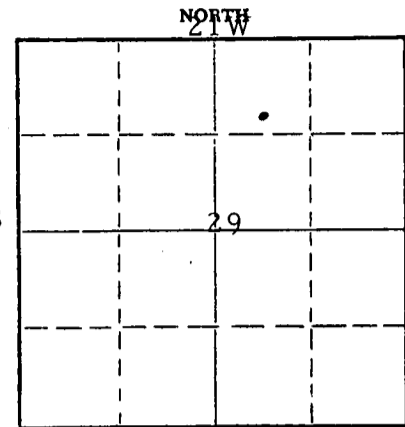

Locate well correctly on above Section Plat

Name of Conservation Agent who supervised plugging of this well W. L. Nichols

Producing formation Marmaton Depth to top 3855' Bottom 3891' Total Depth of Well 3955 Feet

Show depth and thickness of all water, oil and gas formations.

OIL, GAS OR WATER RECORDS

CASING RECORD

FORMATION	CONTENT	FROM	TO	SIZE	PUT IN	PULLED OUT
(Lansing)	water	3582'	3588'	8-5/8"	248'	None
(Marmaton-Ft. Scott)	Oil & water	3870'	3876'	5-1/2"	3954'	3154'

Describe in detail the manner in which the well was plugged, indicating where the mud fluid was placed and the method or methods used in introducing it into the hole. If cement or other plugs were used, state the character of same and depth placed, from \_\_\_\_\_ feet to \_\_\_\_\_ feet for each plug set.

Checked hole to plug-back @ 3935', pushed plug to 3550', sanded to 3540' and dumped 5 sacks of cement @ 3540' with dump bailer. Pulled 5 1/2" casing, bailed fluid to 400', set rock bridge and filled to surface with 6 yards of ready-mix cement.

RECEIVED  
STATE CORPORATION COMMISSION

JAN 11 1966

01-11-1966  
CONSERVATION DIVISION  
Wichita, Kansas

PLUGGING COMPLETE.

Name of Plugging Contractor KNIGHT CASING PULLING COMPANY  
Address P.O. Box 405 CHASE, KANSAS

STATE OF KANSAS, COUNTY OF RICE, ss.  
Noel J. Knight (employee of owner) or (~~owner or operator~~) of the above-described

well, being first duly sworn on oath, says: That I have knowledge of the facts, statements, and matters herein contained and the log of the above-described well as filed and that the same are true and correct. So help me God.

(Signature) Noel J. Knight  
Chase, Kansas  
(Address)

SUBSCRIBED AND SWORN TO before me this 5th day of January, 1966

My commission expires May 20, 1968

Milton J. Volin  
Milton J. Volin Notary Public.

# WELL LOG

COMPANY **Clinton Oil Company**

15-195-30098-00-00  
SEC. 29 T. 12S R. 21W

FARM **Blakely**

NO. **1-X**

LOC. **C - S/2 - NW - NE**


TOTAL DEPTH **3955'**

COUNTY **Irego**

COMM. **6-1-65**

COMP. **6-12-65**

CONTRACTOR **Garvey Drilling Company**

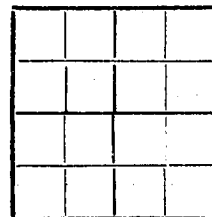

CASING **8 5/8" @ 248' w/200 sx**

**5 1/2" @ 3954' w/125 sx**

ELEVATION

PRODUCTION

FIGURES INDICATE BOTTOM OF FORMATIONS

- 125' Shale
- 251' Shale and Sand
- 870' Shale
- 950' Sand
- 1050' Shale and Shells
- 1415' Shale
- 1650' Shale and Sand
- 1694' Anhydrite
- 2485' Shale and Shells
- 2950' Lime and Shale
- 3200' Shale
- 3320' Shale and Lime
- 3425' Lime and Shale
- 3530' Lime
- 3580' Lime and Shale
- 3615' Lime w/Chert
- 3780' Lime
- 3840' Shale and Lime
- 3945' Lime
- 3955' Conglomerate and Arbuckle
- 3955' RTD

RECEIVED  
STATE LAND COMMISSION  
DEC 27 1965  
12-27-1965  
CONSERVATION DIVISION  
Wichita, Kansas

State of Kansas }  
County of Barton } SS

I, Sam N. Stephens of Garvey Drilling Company

upon oath state the above and foregoing is a true and correct copy of the log of the Blakely #1-X well.

*Sam N. Stephens*

Subscribed and sworn to before me this 25th day of June 19 65

My Commission Expires: May 28, 1969

*Richard H. Dangler*  
NOTARY PUBLIC