

15-195-20950-00-00

STATE OF KANSAS
STATE CORPORATION COMMISSION

WELL PLUGGING RECORD

Give All Information Completely
Make Required Affidavit
Mail or Deliver Report to
Conservation Division
State Corporation Comm.
245 North Water
Wichita, KS 67202

Trego County, Sec. 29 Twp. 12 Rge. 21 E/W
Location as "NE/CNW $\frac{1}{4}$ SW $\frac{1}{4}$ " or footage from lines

NE SE SE
Lease Owner Southern States Oil Company
Lease Name Blakely Well No. #1
Office Address Box 1365 Great Bend, Kansas 67530


Character of Well (Completed as Oil, Gas or Dry Hole)
Dry Hole

Date Well completed 3-6- 1982
Application for plugging filed 3-6- 1982
Application for plugging approved 3-6- 1982
Plugging commenced 11:30 am 3-6 1982
Plugging completed 2:30pm 3-6- 1982

Reason for abandonment of well or producing formation
Dry Hole

If a producing well is abandoned, date of last production
19

Was permission obtained from the Conservation Division or
its agents before plugging was commenced? yes

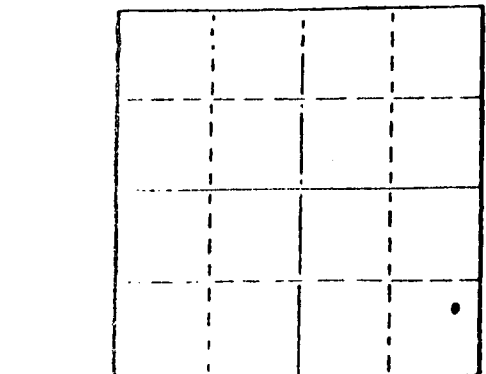

Locate well correctly on above
Section Plat

Name of Conservation Agent who supervised plugging of this well Gilbert Balhazor
Producing formation _____ Depth to top _____ Bottom _____ Total Depth of Well 3930'
Show depth and thickness of all water, oil and gas formations. 8 5/8 @ 259'

OIL, GAS OR WATER RECORDS

CASING RECORD

FORMATION	CONTENT	FROM	TO	SIZE	PUT IN	PULLED OUT

Describe in detail the manner in which the well was plugged, indicating where the mud fluid was placed and the method or methods used in introducing it into the hold. If cement or other plugs were used, state the character of same and depth placed, from _____ feet to _____ feet for each plug set.

Filled hole to 800' with heavy mud and mixed 70 sacks of cement and pumped in hole thru drill pipe.


Filled hole to 260' with heavy mud and mixed 40 sacks of cement and pumped in hole thru Drill pipe.

Filled hole to 40' built a solid bridge and pushed down plug and mixed 10 sacks of cement and filled hole to bottom of cellar; mixed 10 sacks and poured into the rat hole.

All cement used was 50-50 Poz Mix 2% CC 6% Gel
(If additional description is necessary, use BACK of this sheet)

Name of Plugging Contractor Revlin Drlg., Inc.

STATE OF Kansas COUNTY OF Russell, ss.
Stanley C. Lingreen (employee of owner) or (owner or operator)
of the above-described well, being first duly sworn on oath, says: That I have knowledge of the facts, statements, and matters herein contained and the log of the above-described well as filed and that the same are true and correct. So help me God.

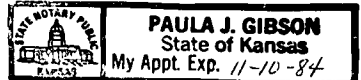

(Signature) Stanley C. Lingreen
Box 293 Russell, Kansas 67665
(Address)

SUBSCRIBED AND SWORN TO before me this 9th day of March, 1982

RECEIVED
STATE CORPORATION COMMISSION
Notary Public.

My commission expires November 10, 1984

MAR 16 1982
3-16-1982
CONSERVATION DIVISION
Wichita, Kansas