

15-163-20027-0000


STATE OF KANSAS  
STATE CORPORATION COMMISSION

Form CP-4

WELL PLUGGING RECORD

Give All Information Completely  
Make Required Affidavit  
Mail or Deliver Report to:  
Conservation Division  
State Corporation Commission  
212 No. Market  
Wichita, Kansas

Rooks County, Sec. 31 Twp. 10s Rge. 20 (E) (W)  
Location as "NE/CNW&SW" or footage from lines NE SE NE  
Lease Owner PETROLEUM, INC.,  
Lease Name THOMAS 'L' Well No. 1  
Office Address R.R. #2, GREAT BEND, KANSAS  
Character of Well (completed as Oil, Gas or Dry Hole) DRY HOLE  
Date well completed JUNE 19 19.67  
Application for plugging filed JUNE 19 19.67  
Application for plugging approved JUNE 19 19.67  
Plugging commenced JUNE 19 19.67  
Plugging completed JUNE 19 19.67  
Reason for abandonment of well or producing formation NO PRODUCIBLE ZONE

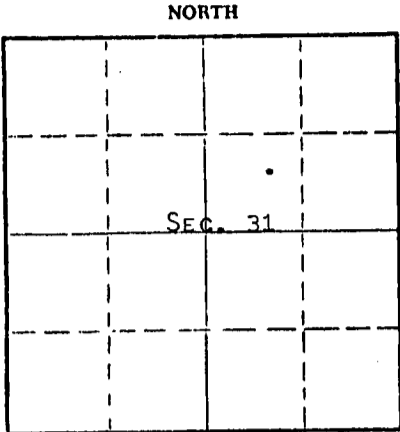

Locate well correctly on above  
Section Plat

If a producing well is abandoned, date of last production NONE 19  
Was permission obtained from the Conservation Division or its agents before plugging was commenced? YES

Name of Conservation Agent who supervised plugging of this well LEO F. MASSEY  
Producing formation \_\_\_\_\_ Depth to top \_\_\_\_\_ Bottom \_\_\_\_\_ Total Depth of Well 3400 Feet  
Show depth and thickness of all water, oil and gas formations.

OIL, GAS OR WATER RECORDS

CASING RECORD

FORMATION	CONTENT	FROM	TO	SIZE	PUT IN	PULLED OUT
				8-5/8"	213'	NONE

Describe in detail the manner in which the well was plugged, indicating where the mud fluid was placed and the method or methods used in introducing it into the hole. If cement or other plugs were used, state the character of same and depth placed, from \_\_\_\_\_ feet to \_\_\_\_\_ feet for each plug set.

MUD TO 550', FOLLOWED BY WOODEN PLUG, PLACED 20 SACKS CEMENT ON TOP OF PLUG.  
MUD TO 210', FOLLOWED BY WOODEN PLUG, PLACED 20 SACKS CEMENT ON TOP OF PLUG.  
MUD TO 40', FOLLOWED BY WOODEN PLUG, PLACED 1/2 SACK HULLS AND 10 SACKS CEMENT ON TOP OF PLUG TO BASE OF WELL CELLAR.

RECEIVED  
JUN 23 1967  
6-23-67  
CONSERVATION DIVISION  
WICHITA, KANSAS

(If additional description is necessary, use BACK of this sheet)  
Name of Plugging Contractor GARVEY DRILLING COMPANY  
Address R.R. #2, GREAT BEND, KANSAS

STATE OF KANSAS, COUNTY OF BARTON, ss.  
MONTE CHADD (employee of owner) or (owner or operator) of the above-described well, being first duly sworn on oath, says: That I have knowledge of the facts, statements, and matters herein contained and the log of the above-described well as filed and that the same are true and correct. So help me God. MONTE CHADD, DIST. PROD. SUPT.

(Signature) Monte Chadd  
R.R. #2, GREAT BEND, KANSAS  
(Address)

SUBSCRIBED AND SWORN TO before me this 21 day of JUNE 19 67

Richard H. Dumbler  
Notary Public.

My commission expires MAY 28, 1969

# WELL LOG

COMPANY Petroleum, Inc.

SEC. 31 T. 10S R. 20W

FARM Thomas L

NO. 1

LOC. NE SE NE


TOTAL DEPTH 3400'

COUNTY Rooks, Kansas

COMM. 6-14-67

COMP. 6-19-67

CONTRACTOR Garvey Drilling Company

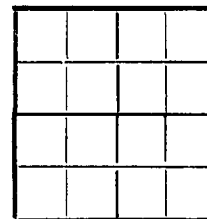

CASING

8 5/8" @ 213' w/175 sx

ELEVATION 2060' KB

PRODUCTION D & A

FIGURES INDICATE BOTTOM OF FORMATIONS

- 190' Top Soil, Shale and Shells
- 213' Blue Shale
- 590' Shale and Shells
- 1020' Shale and Clay
- 1080' Sand
- 1275' Sand and Shale
- 1524' Shale and Shells
- 1573' Anhydrite
- 1750' Chugwater and Shale
- 2110' Lime and Shale
- 2212' Chalk and Shale
- 2425' Shale, Lime and Chalk
- 2710' Lime and Shale
- 2739' Shale and Lime
- 3270' Lime and Shale
- 3354' Lime with Shale
- 3400' Lime
- 3400' RTD

**RECEIVED**  
 STATE CORPORATION COMMISSION  
 JUN 28 1967  
 CONSERVATION DIVISION  
 Wichita, Kansas

State of Kansas }  
 County of Barton } ss

I, James R. Rodgers of Garvey Drilling Company

upon oath state the above and foregoing is a true and correct copy of the log of the Thomas L No. 1 well.

James R. Rodgers

Subscribed and sworn to before me this 20th day of June 1967

My Commission Expires: November 5th, 1969

Richard A. Boyer  
 NOTARY PUBLIC