


15-163-00864-0000

STATE OF KANSAS  
STATE CORPORATION COMMISSION  
Give All Information Completely  
Make Required Affidavit  
Mail or Deliver Report to:  
Conservation Division  
State Corporation Commission  
800 Biting Building  
Wichita, Kansas

WELL PLUGGING RECORD

Rooks County. Sec. 31 Twp. 10 Rge.      (E) 20 (W)  
Location as "NE/CNW/SW" or footage from lines SW SW NE/4  
Lease Owner Herman George Kaiser, Oil Producer  
Lease Name Schneider D Well No. 1  
Office Address 908 Palace Building, Tulsa, Oklahoma  
Character of Well (completed as Oil, Gas or Dry Hole) Dry Hole  
Date well completed Aug. 20 19 55  
Application for plugging filed      " " 19       
Application for plugging approved      " " 19       
Plugging commenced      " 21 19       
Plugging completed      " " 19       
Reason for abandonment of well or producing formation dry

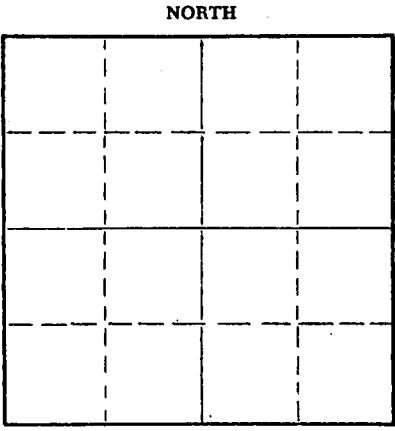

Locate well correctly on above Section Plat

If a producing well is abandoned, date of last production      19       
Was permission obtained from the Conservation Division or its agents before plugging was commenced? Yes

Name of Conservation Agent who supervised plugging of this well Warren H. Horner  
Producing formation      Depth to top      Bottom      Total Depth of Well 3710 Feet  
Show depth and thickness of all water, oil and gas formations.

OIL, GAS OR WATER RECORDS

CASING RECORD

FORMATION	CONTENT	FROM	TO	SIZE	PUT IN	PULLED OUT
				8 5/8"	194'	None

Describe in detail the manner in which the well was plugged, indicating where the mud fluid was placed and the method or methods used in introducing it into the hole. If cement or other plugs were used, state the character of same and depth placed, from      feet to      feet for each plug set.

Mudded hole to 180 ft., set plug at 180 ft. and cemented with 1/2 sack hulls and 15 sacks cement through drill pipe.  
Mudded hole to 40 ft., set plug and 1/2 sack hulls and 10 sacks cement to surface.

(If additional description is necessary, use BACK of this sheet)

Name of Plugging Contractor H-30, Inc.  
Address 710 Petroleum Bldg., Wichita, Kansas

STATE OF KANSAS, COUNTY OF SEDGWICK, ss.  
L. C. Sponenberg (employee of owner) or (owner or operator) of the above-described well, being first duly sworn on oath, says: That I have knowledge of the facts, statements, and matters herein contained and the log of the above-described well as filed and that the same are true and correct. So help me God.

(Signature) [Signature]  
(Address)     

SUBSCRIBED AND SWORN to before me this 23rd day of August, 19 55

My commission expires February 13, 1956. Rose Furey Notary Public.

