

15-163-03264-0000


STATE OF KANSAS
STATE CORPORATION COMMISSION

WELL PLUGGING RECORD

Give All Information Completely
Make Required Affidavit
Mail or Deliver Report to:
Conservation Division
State Corporation Commission
800 Bitting Building
Wichita, Kansas

Rooks County, Sec. 31 Twp. 10S Rge. 20 (W)

Location as "NE/CNW/SE/SW" or footage from lines NE NW NW
Lease Owner Magnolia Petroleum Co.
Lease Name Theodore SCHNEIDER Well No. 1
Office Address Box 900 - Dallas, Texas
Character of Well (completed as Oil, Gas or Dry Hole) Dry hole
Date well completed 5-17-53 19
Application for plugging filed 8-12-53 19
Application for plugging approved 8-13-53 19
Plugging commenced 8-15-53 19
Plugging completed 8-20-53 19
Reason for abandonment of well or producing formation Well drilled dry

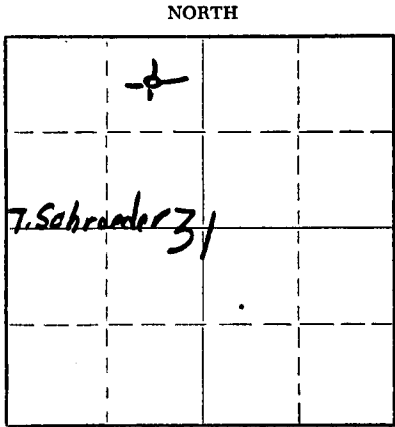

Locate well correctly on above
Section Plat

If a producing well is abandoned, date of last production - 19
Was permission obtained from the Conservation Division or its agents before plugging was commenced? Yes

Name of Conservation Agent who supervised plugging of this well Eldon Petty
Producing formation None Depth to top Bottom Total Depth of Well 3749 Feet
Show depth and thickness of all water, oil and gas formations.

OIL, GAS OR WATER RECORDS

CASING RECORD

FORMATION	CONTENT	FROM	TO	SIZE	PUT IN	PULLED OUT
				8-5/8	220	None
				5-1/2	3748	2665

Describe in detail the manner in which the well was plugged, indicating where the mud fluid was placed and the method or methods used in introducing it into the hole. If cement or other plugs were used, state the character of same and depth placed, from feet to feet for each plug set.

Filled hole w/sand fr 3515 to 3490'; dumped 4 sx cmnt. Top of cmnt 3458'. Filled hole w/mud to 245'; put in 10' rock bridge to 235', mixed & ran 15 sx cmnt. Top of cmnt @ 190'. Filled w/mud fr 190' to 35'. Put in 5' rock bridge to 30'; mixed & ran 10 sx cmnt. Filled to btm of cellar.

All plugging & mudding done as per Mr. Eldon Petty, State Plugger.

(If additional description is necessary, use BACK of this sheet)
Name of Plugging Contractor Jayhawk Casing Pulling Co., Permit #19
Address Russell, Kansas

STATE OF KANSAS, COUNTY OF BARTON, ss.
C. A. Hill (employee of owner) of the above-described well, being first duly sworn on oath, says: That I have knowledge of the facts, statements, and matters herein contained and the log of the above-described well as filed and that the same are true and correct. So help me God.

(Signature) [Signature]
Box 770 - Great Bend, Kansas (Address)

SUBSCRIBED AND SWORN TO before me this 8th day of September, 1953

My commission expires Jan. 14, 1957

[Signature] Notary Public
STATE CORPORATION COMMISSION

PLUGGING
FILE SEC 31 T 10 R 20W
BOOK PAGE 121 LINE 25

SEP 11 1953
9-11-53
CONC. DIVISION
WICHITA, KANSAS

15-163-03264-0000

WELL LOG

Theodore SCHNEIDER #1 ROOKS COUNTY CHASE DISTRICT STATE OF KANSAS
NE NW NW Section Sec. 31-10S-20W

DRILLING COMMENCED 4/16/53 Barnett Drilling Company
DRILLING COMPLETED 4/29/53 Wichita, Kansas

8 5/8" 24.0 8 RT J-55 R 2 9 Jts 220' cmnt w/150 sx cmnt circulated 4/16/53
5 1/2" 14.0 8 RT R 2 120 jts 3748' cmnt w/200 sx cmnt 4/30/53

Elevation: 2138' KB Kelly bushing to Gr. Elev 4'

FORMATION

Surface	0	10
Shale	10	60
Sandy Shale	60	90
Shale	90	220
Shale & Shells	220	720
Sand	720	830
Sandy Shale	830	1300
Shale	1300	1600
Anhydrite	1600	1638
Shale & Shells	1638	2185
Lime & Shale	2185	2510
Lime	2510	2565
Lime & Shale	2565	3405
LOST CIRCULATION @ 3230'		
Lime	3405	3748 TD

OIL STRING SET @ 3748'
PLUG BACK DEPTH None

AVERAGE HOLE DIAMETER - 7 7/8"

COMPLETION HISTORY:

May 5, 1953 drilled plug to 3740', perf 3729-32' w/12 shots, set plug @ 3725 perf 3710-20 w/40 Jet shots, hydrafrac #1, May 8 set plug @ 3708, perf 3702-06 w/24 shots, hydrafrac #2 (1 ft calseal on 3708'P), May 11 acidized, May 13 set plug @ 3650, perf 3638-45 w/42 jet shots, acidized #2, May 14 set plug @ 3595, perf 3582-88 w/32 Jet shots acidized #3, May 16 set plug @ 3515 perf 3504-10 w/36 Jet Shots, acidized #4, May 17 well temp abd - holding for possible Salt Water Disposal Well.

PLUGGING
FILE SEC 31 T 10 R 20W
BOOK PAGE 121 LINE 25

STATE OF KANSAS
9-11-53
CONSERVATION DIVISION