


Give All Information Completely
Make Required Affidavit
Mail or Deliver Report to:
Conservation Division
State Corporation Commission
211 No. Broadway
Wichita, Kansas

WELL PLUGGING RECORD

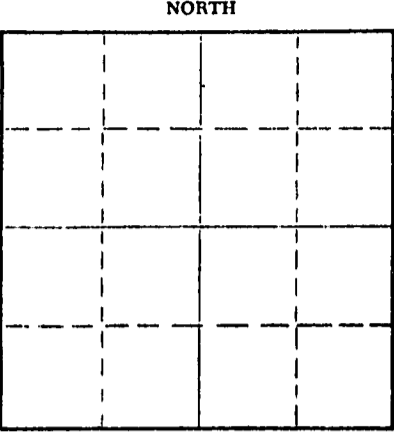

Rooks _____ County, Sec. 31 Twp. 10S Rge. 20 (E) X (W)
Location as "NE/CNW/SW" or footage from lines _____
Lease Owner Thunderbird Drilling, Inc.
Lease Name Hamilton "A" Well No. 1
Office Address P. O. Box 18407- Wichita, Kansas 67218
Character of Well (completed as Oil, Gas or Dry Hole) Dry Hole
Date well completed 6/25/77 _____ 19
Application for plugging filed 6/25/77 _____ 19
Application for plugging approved 6/25/77 _____ 19
Plugging commenced 6/25/77 _____ 19
Plugging completed 6/25/77 _____ 19
Reason for abandonment of well or producing formation Dry Hole

If a producing well is abandoned, date of last production _____ 19
Was permission obtained from the Conservation Division or its agents before plugging was commenced? _____

Name of Conservation Agent who supervised plugging of this well Leo Massey
Producing formation _____ Depth to top _____ Bottom _____ Total Depth of Well 3692 Feet
Show depth and thickness of all water, oil and gas formations.

OIL, GAS OR WATER RECORDS				CASING RECORD		
FORMATION	CONTENT	FROM	TO	SIZE	PUR IN	PULLED OUT
				8-5/8"	322	0

Describe in detail the manner in which the well was plugged, indicating where the mud fluid was placed and the method or methods used in introducing it into the hole. If cement or other plugs were used, state the character of same and depth placed, from _____ feet to _____ feet for each plug set.

1st Plug @ 720' w/70 sx
2nd Plug @ 250' w/40 sx
3rd Plug @ 40' w/10 sx

7-12-77

(If additional description is necessary, use BACK of this sheet)
Name of Plugging Contractor Thunderbird Drilling, Inc.
Address P. O. Box 18407- Wichita, Kansas 67218

STATE OF KANSAS COUNTY OF SEDGWICK, ss.
Burke Krueger (employee of owner) or (owner or operator) of the above-described well, being first duly sworn on oath, says: That I have knowledge of the facts, statements, and matters herein contained and the log of the above-described well as filed and that the same are true and correct. So help me God.

(Signature) Burke Krueger
P. O. Box 18407- Wichita, Kansas 67218
(Address)

SUBSCRIBED AND SWORN to before me this 5th day of July, 1977

My commission expires 3-25-80
Gloria DeJesus
Gloria DeJesus Notary Public.



