


WELL PLUGGING RECORD

Give All Information Completely
Make Required Affidavit
Mail or Deliver Report to:
Conservation Division
State Corporation Commission
800 Bittling Building
Wichita, Kansas

Rooks County. Sec. 31 Twp. 10S Rge. 20 (W)
Location as "NE/CNW/SW" or footage from lines NW SW NW
Lease Owner Magnolia Petroleum Company
Lease Name Theodore Schneider Well No. 4
Office Address Box 770, Great Bend, Kansas
Character of Well (completed as Oil, Gas or Dry Hole) Dry Hole
Date well completed 6 - 9 19 58
Application for plugging filed 6 - 9 19 58
Application for plugging approved Verbal 6 - 9 19 58
Plugging commenced 6 - 9 19 58
Plugging completed 6 - 9 19 58
Reason for abandonment of well or producing formation Dry Hole

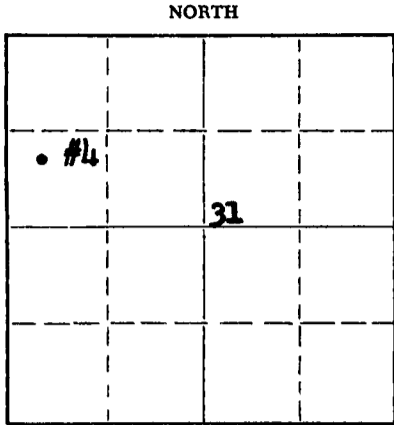

Locate well correctly on above Section Plat

If a producing well is abandoned, date of last production - 19 -
Was permission obtained from the Conservation Division or its agents before plugging was commenced? Yes - verbal

Name of Conservation Agent who supervised plugging of this well Eldon Petty - Box 326, Hays, Kansas
Producing formation Dry Hole Depth to top - Bottom - Total Depth of Well 3800 Feet
Show depth and thickness of all water, oil and gas formations.

OIL, GAS OR WATER RECORDS

CASING RECORD

FORMATION	CONTENT	FROM	TO	SIZE	PUT IN	PULLED OUT
-	Dry	-	-	8-5/8"	360'	None

Describe in detail the manner in which the well was plugged, indicating where the mud fluid was placed and the method or methods used in introducing it into the hole. If cement or other plugs were used, state the character of same and depth placed, from _____ feet to _____ feet for each plug set.

Filled hole w/mud fr 3800 to 500'. Set wood plug and 20 sx cmnt @ 500'. Filled w/mud to 240'. Set wood plug and 20 sx cmnt to 40'. Set wood plug and 1/2 sack bulls plus 10 sx cmnt to base of cellar. Plate welded over surf csg 3' below surf & leveled w/dirt.

6-12-58

(If additional description is necessary, use BACK of this sheet)

Name of Plugging Contractor Peel Brothers, Inc.
Address Hoisington, Kansas

STATE OF Kansas, COUNTY OF Barton, ss. J. T. Rosenberger (employee of owner) or (agent of owner) of the above-described well, being first duly sworn on oath, says: That I have knowledge of the facts, statements, and matters herein contained and the log of the above-described well as filed and that the same are true and correct. So help me God.

(Signature) J. T. Rosenberger
Box 770, Great Bend, Kansas (Address)

SUBSCRIBED AND SWORN TO before me this 11th day of June 19 58
Harriett L. Kaiser Notary Public.

My commission expires January 11, 1961

PLUGGING
FILE SEC. T. R.
BOOK PAGE LINE

PLUGGING
FILE SEC. 31 T. 10 R. 20W
BOOK PAGE 106 LINE 25

Orig: Corp. Comm. ✓
cc: Eldon Petty
File

15-163-12427-0000


WELL LOG BUREAU—KANSAS GEOLOGICAL SOCIETY
508 East Murdock, Wichita, Kansas

Company- MOBIL OIL CO.
Farm- Theodore Schneider No. 4

SEC. 31 T. 10 R. 20W
NW SW NW
330' FWL 990' FSL

Total Depth. 3301'
Comm. 5-30-58 Comp. 6-9-58
Shot or Treated,
Contractor. Peel Brothers, Inc.
Issued. 7-16-60

County Rooks
KANSAS

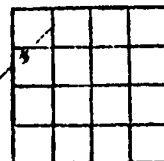

Elevation. 2134'

Production. DRY

CASING:

8 5/8" 360' w/275 sx cem.

Figures Indicate Bottom of Formations. --

shale, sand stks	160
shale	450
shale, shells	1080
sand	1300
shale red bed	1585
anhydrite	1895
shale	2280
shale, lime	2685
lime, shale	3205
shale, lime	3460
lime	3690
shale, lime	3800 RTD
shale, lime	3801
Total Depth	

TQPS:

Anhydrit (scout)	1585
Topeka	2168
Hcebner	3376
Toronto	3397
Lansing KC	3415
Conglomerate	3696
cherty Conglomerate	3752