


WELL PLUGGING RECORD

Give All Information Completely  
Make Required Affidavit  
Mail or Deliver Report to:  
Conservation Division  
State Corporation Commission  
800 Bitting Building  
Wichita, Kansas

NORTH

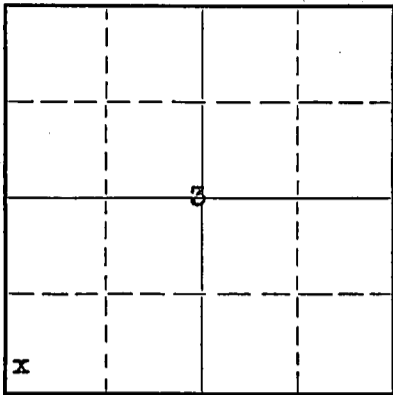

Locate well correctly on above Section Plat

Graham County. Sec. 3 Twp. 10S Rge. 2E 21(W)  
Location as "NE/CNW $\frac{1}{4}$ SW $\frac{1}{4}$ " or footage from lines SW SW SW  
Lease Owner Anderson-Prichard Oil Corp.  
Lease Name Miller Well No. 1  
Office Address Box 142, Great Bend, Kansas  
Character of Well (completed as Oil, Gas or Dry Hole) oil  
Date well completed 10-21 19 50  
Application for plugging filed 5-19 19 52  
Application for plugging approved 5-19 19 52  
Plugging commenced 5-20 19 52  
Plugging completed 5-25 19 52  
Reason for abandonment of well or producing formation Casing failure  
If a producing well is abandoned, date of last production 12-28 19 51  
Was permission obtained from the Conservation Division or its agents before plugging was commenced? Yes

Name of Conservation Agent who supervised plugging of this well Eldon Petty  
Producing formation Arbuckle Depth to top 3826' Bottom  Total Depth of Well 3829' Feet  
Show depth and thickness of all water, oil and gas formations.

OIL, GAS OR WATER RECORDS

CASING RECORD

Formation	Content	From	To	Size	Put In	Pulled Out
				10 3/4"	244'	None
				5 1/2"	3827'	610'

Describe in detail the manner in which the well was plugged, indicating where the mud fluid was placed and the method or methods used in introducing it into the hole. If cement or other plugs were used, state the character of same and depth placed, from \_\_\_\_\_ feet to \_\_\_\_\_ feet for each plug set.

Hole plugged at 3700' w/Lane Wells Plug  
Shot casing off at 610' - Pulled casing  
Filled hole w/heavy mud to 240'  
Set permanent rock bridge at 240'  
Dumped 20 sax cement on bridge.  
Filled hole w/mud to 30'  
Mixed 10 sax cement for cap on well.

(If additional description is necessary, use BACK of this sheet)

Correspondence regarding this well should be addressed to W. J. Dearen, c/o Anderson Prichard Oil Corp.  
Address Box 142, Great Bend, Kansas

STATE OF KANSAS, COUNTY OF BARTON, ss.  
Gerald M. Dougherty (employee of owner) or owner/proprietor of the above-described well, being first duly sworn on oath, says: That I have knowledge of the facts, statements, and matters herein contained and the log of the above-described well as filed and that the same are true and correct. So help me God.

(Signature) Gerald M. Dougherty  
Box 142, Great Bend, Kansas  
(Address)

SUBSCRIBED AND SWORN to before me this 3rd day of June, 19 52

My commission expires Dec. 4, 1954

RECEIVED  
STATE CORPORATION COMMISSION  
Notary Public.

23-5021-8  
8-50-10M JUN 4 - 1952  
CONSERVATION DIVISION  
Wichita, Kansas

PLUGGING  
FILE 633-3710-210  
BOOK PAGE 19 LINE 13

MILLER NO. 1 WELL

LOCATION: SW $\frac{1}{4}$  SW $\frac{1}{4}$  SW $\frac{1}{4}$  Sec. 3-10S-21W  
Graham County, Kansas

OPERATOR: Anderson-Prichard Oil Corporation

CONTRACTOR: Birmingham-Bartlett Drilling Co.

SURFACE CASING: Ran 8 jts., 248' of 10-3/4" casing  
cemented @ 244' with 160 sacks  
cement and 2 cc.

OIL STRING: Ran 124 jts., 3839' 5 $\frac{1}{2}$ " 14# casing  
cemented @ 3827' with 125 sacks  
cement.

SPUDED: 9-10-50  
COMPLETED: 9-21-50

L O G

(Figures indicate bottom of formation)

0	to	244	Surface
		880	Shale
		1200	Sand and shale
		1450	Sand
		1530	Shale
		1725	Shale and red bed
		1765	Anhydrite
		2090	Shale and shells
		2275	Shale
		2905	Shale and lime
		2995	Shale and shells
		3170	Shale
		3515	Shale and lime
		3770	Lime
		3815	Lime and conglomerate
		3826	Conglomerate
		3828	Arbuckle
		3828	Total Depth.

The undersigned Richard Hindery of the Birmingham-Bartlett Drilling Co. hereby certifies that the above is a true and correct log of the formations encountered in drilling the Miller No. 1 well as shown on the daily drilling reports.

BIRMINGHAM-BARTLETT DRILLING CO.

BY Richard Hindery

Subscribed and sworn before me  
this 25th day of September, 1950.

Lincoln J. Zinger  
Notary Public

My commission expires November 29, 1950.

**PLUGGING**  
FILE SEC-3 T-19R-211  
BOOK PAGE-19 LINE-13

**RECEIVED**  
CORPORATION COMMISSION  
JUN 4 - 1952  
INSPECTION DIVISION  
Wichita, Kansas