


15-065-02585-0000

STATE OF KANSAS
STATE CORPORATION COMMISSION

WELL PLUGGING RECORD

Give All Information Completely
Make Required Affidavit
Mail or Deliver Report to:
Conservation Division
State Corporation Commission
800 Bitting Building
Wichita, Kansas

NORTH

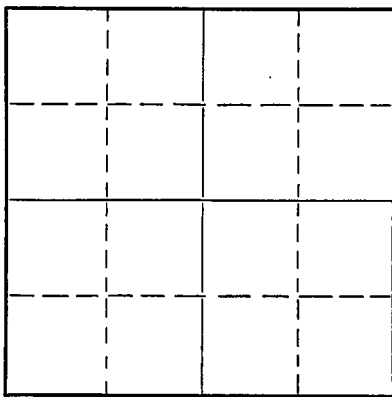

Locate well correctly on above
Section Plat

Graham County. Sec. 3 Twp. 10 Rge. (E) 21 (W)
Location as "NE/CNW $\frac{1}{4}$ SW $\frac{1}{4}$ " or footage from lines NE/4 SW NE
Lease Owner Phillips Petroleum Company
Lease Name Trible Well No. 6
Office Address Box 779 - Great Bend, Kansas.
Character of Well (completed as Oil, Gas or Dry Hole) Dry Hole
Date well completed 7/31/51 19
Application for plugging filed 8/1/51 19
Application for plugging approved 8/1/51 19
Plugging commenced 8/1/51 19
Plugging completed 8/1/51 19
Reason for abandonment of well or producing formation Dry Hole

If a producing well is abandoned, date of last production - - - - 19
Was permission obtained from the Conservation Division or its agents before plugging was commenced? Yes

Name of Conservation Agent who supervised plugging of this well Mr. Eldon Petty
Producing formation Arubkle Depth to top 3887' Bottom 3942 Total Depth of Well 3942 Feet
Show depth and thickness of all water, oil and gas formations.

OIL, GAS OR WATER RECORDS

CASING RECORD

Formation	Content	From	To	Size	Put In	Pulled Out
Anhydrite	Dry	1790	1807	8 5/8"	1809	None
Arubckle	Dry	3887	3942		None	

Describe in detail the manner in which the well was plugged, indicating where the mud fluid was placed and the method or methods used in introducing it into the hole. If cement or other plugs were used, state the character of same and depth placed, from.....feet to.....feet for each plug set.

Spotted 25 sx. cement 3942 to 3870'. Mudded hole to 250' and set wood plug at 250'.
Dumped 25 sx. cement from 250' to 175', mudded hole to 55', dumped 25 sx. cement
in filling to surface. Well Plugged and abandoned 3:00 PM 8/1/51.

(If additional description is necessary, use BACK of this sheet)

Correspondence regarding this well should be addressed to Mr. A. J. Willis
Address Box 779 - Great Bend, Kansas.

STATE OF KANSAS, COUNTY OF BARTON, ss.
Mr. A. J. Willis (employee of owner) or (owner or operator) of the above-described well,

being first duly sworn on oath, says: That I have knowledge of the facts, statements, and matters herein contained and the log of the above-described well as filed and that the same are true and correct. So help me God.

(Signature) [Signature]
Box 779 - Great Bend, Kansas.
(Address)

SUBSCRIBED AND SWORN to before me this 1 st day of August 19 51

My commission expires November 18, 1953 Joseph M. Beal Notary Public.

23-3273-s 4-50-10M

AUG 3 X 1951

PLUGGING
FILE SEC 3 T 10 R 10
BOOK PAGE 99 LINE 43

CON. DIVISION
Wichita, Kansas

15-065-02585-0000

Formation Record

Lease

Tribble

Well No.

6

FROM	TO	Formation	REMARKS
0	45	Sand and Clay	
45	1015	Sand and Shale	
1015	1225	Sand, Shale and Pyrite	
1225	1440	Pyrite and Sand	
1440	1650	Sand, Shale and Pyrite	
1650	1807	Shale, Sand, Redbed and Anhydrite	
1807	2080	Anhydrite and Shale	
2080	2429	Lime and Shale	
2429	2604	Lime and Shale Streaks	
2604	2726	Lime and Shale	
2726	2900	Shale	
2900	3060	Lime and Shale	
3060	3173	Shale and Lime Streaks	
3173	3374	Lime and Shale	
3374	3942	Lime	

PLUGGING
 FILE SEC 3 T 10 R W
 BOOK PAGE 99 LINE 43

AUG 3 X 1951

REGISTRATION