


Give All Information Completely  
Make Required Affidavit  
Mail or Deliver Report to:  
Conservation Division  
State Corporation Commission  
211 No. Broadway  
Wichita, Kansas

**WELL PLUGGING RECORD**

NORTH

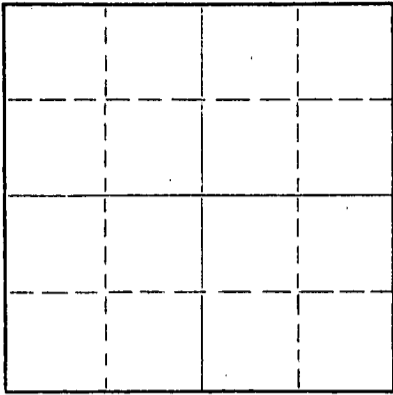

Locate well correctly on above  
Section Plat

Graham County, Sec. 4 Twp. 10 Rge. 21 (E) (W)  
Location as "NE/CNW/SW" or footage from lines NW/SW/NW W/2 NW/9  
Lease Owner Morgenstern & Spector  
Lease Name Rudman "A" Well No. #2  
Office Address Russell, Kansas  
Character of Well (completed as Oil, Gas or Dry Hole) oil  
Date well completed 2-24-54 19\_\_  
Application for plugging filed July 24, 1961 19\_\_  
Application for plugging approved July 25, 1961 19\_\_  
Plugging commenced July 19 1961 19\_\_  
Plugging completed July 28 1961 19\_\_  
Reason for abandonment of well or producing formation failure to produce profitably  
If a producing well is abandoned, date of last production 19\_\_  
Was permission obtained from the Conservation Division or its agents before plugging was commenced? Yes

Name of Conservation Agent who supervised plugging of this well Eldon Petty Hays, Kansas  
Producing formation Arbuckle Depth to top 3894 Bottom 3939 Total Depth of Well 3939 Feet  
Show depth and thickness of all water, oil and gas formations.

OIL, GAS OR WATER RECORDS

CASING RECORD

FORMATION	CONTENT	FROM	TO	SIZE	PUT IN	PULLED OUT
				8 5/8"OD	160 ft.	none
				5 1/2"OD	3930 ft.	1066 ft.

Describe in detail the manner in which the well was plugged, indicating where the mud fluid was placed and the method or methods used in introducing it into the hole. If cement or other plugs were used, state the character of same and depth placed, from \_\_\_\_\_ feet to \_\_\_\_\_ feet for each plug set.

Plugged back with sand to 3200 feet, Dumped 4 sacks - cement.  
Circulated mud at 500 feet, Pumped 20 sacks cement.  
Pumped 20 sacks cement at 160 feet.  
Set a rock bridge at 40 feet, Dumped ten sacks cement.

**RECEIVED**  
STATE CORPORATION COMMISSION  
AUG 21 1961  
CONSERVATION DIVISION  
Wichita, Kansas

(If additional description is necessary, use BACK of this sheet)  
Name of Plugging Contractor LYNCH CASING PULLING COMPANY NO. 457  
Address R. Rt. 4 GREAT BEND, KANSAS

STATE OF Kansas, COUNTY OF Russell, ss.  
Morgenstern & Spector (employee of owner) or (owner or operator) of the above-described well, being first duly sworn on oath, says: That I have knowledge of the facts, statements, and matters herein contained and the log of the above-described well as filed and that the same are true and correct. So help me God.

(Signature) [Signature]  
Russell, Kansas (Address)

SUBSCRIBED AND SWORN TO before me this 1st day of August, 1961

My commission expires Feb. 29, 1964  
Barbara Gortrey Notary Public.

