

15-065-03022-0000

Form CP-4


STATE OF KANSAS
STATE CORPORATION COMMISSION

Give All Information Completely
Make Required Affidavit
Mail or Deliver Report to:
Conservation Division
State Corporation Commission
211 No. Broadway
Wichita, Kansas

WELL PLUGGING RECORD

Graham County. Sec. 5 Twp. 10 Rge. 21 (E) (W) X
Location as "NE/CNW/SW" or footage from lines SE SE SE SW
Lease Owner Okmar Oil Co.
Lease Name Abiram A Well No. #1
Office Address 817 Union National Center Wichita, Kansas
Character of Well (completed as Oil, Gas or Dry Hole) _____
Date well completed _____ 19____
Application for plugging filed _____ 19____
Application for plugging approved _____ 19____
Plugging commenced 6-7-63 19____
Plugging completed 6-9-63 19____
Reason for abandonment of well or producing formation _____

NORTH

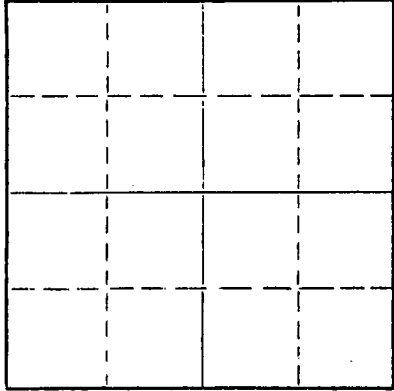

Locate well correctly on above Section Plat

If a producing well is abandoned, date of last production _____ 19____
Was permission obtained from the Conservation Division or its agents before plugging was commenced? _____

Name of Conservation Agent who supervised plugging of this well W. L. Nichols
Producing formation _____ Depth to top _____ Bottom _____ Total Depth of Well 3875' Feet
Show depth and thickness of all water, oil and gas formations.

OIL, GAS OR WATER RECORDS

CASING RECORD

FORMATION	CONTENT	FROM	TO	SIZE	PUT IN	PULLED OUT

Describe in detail the manner in which the well was plugged, indicating where the mud fluid was placed and the method or methods used in introducing it into the hole. If cement or other plugs were used, state the character of same and depth placed, from _____ feet to _____ feet for each plug set.

Sanded back to 3590', mixed and dumped 5 sacks cement.
Pulled 10 joints, mixed and pumped 10 sacks gel. Pulled 3 joints, mixed and pumped 6 sacks gel. No Circulation. Mixed and pumped 9 sacks gel and 5 sacks cotton seed hulls. Pulled 5 joints and mixed and pumped 20 sacks cement to 300'. Pulled 3 joints and mixed and pumped 20 sacks cement to 190'. Pulled 9 joints. Baled hole to 30' and dumped 10 sacks cement for top cap.

RECEIVED
STATE CORPORATION COMMISSION

JUN 12 1963

CONSERVATION DIVISION
Wichita, Kansas

(If additional description is necessary, use BACK of this sheet)
Name of Plugging Contractor Southwest Casing Pulling Co., Inc.
Address Box 364, Great Bend, Kansas

STATE OF Kansas, COUNTY OF Barton, ss.
Southwest Casing Pulling Co., Inc. (employee of owner) or (owner or operator) of the above-described well, being first duly sworn on oath, says: That I have knowledge of the facts, statements, and matters herein contained and the log of the above-described well as filed and that the same are true and correct. So help me God.

(Signature) W. C. Spencer Sec.
Box 364, Great Bend, Kansas
(Address)

SUBSCRIBED AND SWORN TO before me this 10 day of June, 1963

My commission expires 24 October 1964
Sidney D. Miller
Notary Public.

CERTIFIED DRILLER'S LOG

COMPANY: OKMAR OIL COMPANY LEASE: ABIRAM "A" #1
 CONTRACTOR: H & H Drilling Company LOCATION: SE SE SW
 COMMENCED: 11-27-54 4-10-21W
 Grahams County, Kansas
 COMPLETED: 12-8-54 CASING RECORD:
 204' of 8-5/8", cemented w/150 sacks
 ELEVATION: 2273 RB 3852' of 5-1/2", cemented w/150 sacks
 POTENTIAL:

<u>FORMATION</u>	<u>DEPTH</u>
Post Rock Shale	0 - 70
Blue Shale	70 - 204
Shale	204 - 860
Sand and Shale	860 - 1011
Anhydrite	1011 - 1035
Sand and Shale	1035 - 1220
Shale and Shells	1220 - 1745
Anhydrite	1745 - 1775
Lime and Shale	1775 - 1830
Red Bed and Shales	1830 - 1970
Shale and Shells	1970 - 2180
Shale and Lime	2180 - 2360
Lime	2360 - 2515
Lime and Shale	2515 - 2640
Lime	2640 - 2885
Lime and Shale	2885 - 3005
Lime	3005 - 3130
Lime and Shale	3130 - 3303
Lime	3303 - 3380
Lime and Shale	3380 - 3428
Lime	3428 - 3855
RTD	3855

RECEIVED
STATE CORPORATION COMMISSION

APR 23 1963

CONSERVATION DIVISION
Wichita, Kansas

I hereby certify that this is a true and correct copy of the above log to the best of my knowledge.


H. E. HARTMAN

STATE OF KANSAS)
) SS
COUNTY OF SEDGWICK)

Subscribed and sworn to before me this 11th day of December, 1954.


Notary Public

My Commission Expires: August 25, 1956