


15-065-02284-0000

STATE OF KANSAS
STATE CORPORATION COMMISSION
Give All Information Completely
Make Required Affidavit
Mail or Deliver Report to:
Conservation Division
State Corporation Commission
800 Bitting Building
Wichita, Kansas

WELL PLUGGING RECORD

Graham County, Sec. 4 Twp. 10S Rge. 21 (W)
Location as "NE/CNW $\frac{1}{4}$ SW $\frac{1}{4}$ " or footage from lines SW $\frac{1}{4}$ NE $\frac{1}{4}$ SW $\frac{1}{4}$
Lease Owner Heathman Drilling Co., Inc., et al
Lease Name ABIRAM Well No. 2
Office Address 509 Orpheum Bldg., Wichita, Kansas
Character of Well (completed as Oil, Gas or Dry Hole) dry hole
Date well completed 8-12-1950
Application for plugging filed (verbal 8-12-50) (written 8-17-1950)
Application for plugging approved (verbal 8-12-50)
Plugging commenced 8-12-1950
Plugging completed 8-12-1950
Reason for abandonment of well or producing formation --- dry hole ---
If a producing well is abandoned, date of last production 19
Was permission obtained from the Conservation Division or its agents before plugging was commenced? yes

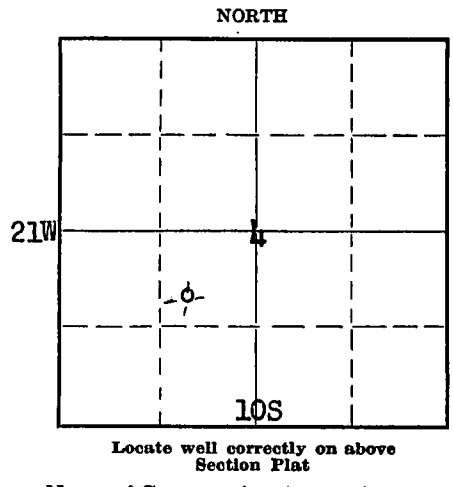

Name of Conservation Agent who supervised plugging of this well Eldon Petty, Hays, Kansas
Producing formation --- Depth to top --- Bottom --- Total Depth of Well 3917 Feet
Show depth and thickness of all water, oil and gas formations.

OIL, GAS OR WATER RECORDS

CASING RECORD

Formation	Content	From	To	Size	Put In	Pulled Out
none	---	---	---	8-5/8"	140'	none
				cemented w/100 sacks cement and 1 sack CC		
				D&A no oil string run		

Describe in detail the manner in which the well was plugged, indicating where the mud fluid was placed and the method or methods used in introducing it into the hole. If cement or other plugs were used, state the character of same and depth placed, from _____ feet to _____ feet for each plug set.

Bottom hole plug @ 135' w/15 sacks cement; top plug @ 40' w/10 sacks cement to surface.


08-18-50

(If additional description is necessary, use BACK of this sheet)
Correspondence regarding this well should be addressed to Heathman Drilling Co., Inc.,
Address 509 Orpheum Bldg., Wichita, Kansas

STATE OF Kansas, COUNTY OF Sedgwick, ss.
Robert F. Walters (employee of owner) of the above-described well,
being first duly sworn on oath, says: That I have knowledge of the facts, statements, and matters herein contained and the log of the above-described well as filed and that the same are true and correct. So help me God.
(Signature) by: Robert F. Walters
509 Orpheum Bldg., Wichita, Kansas (Address)

SUBSCRIBED AND SWORN TO before me this 17th day of August, 1950

My commission expires June 28, 1952. Notary Public.

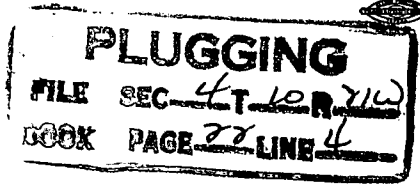

15-065-02284-0000

DRILLER'S LOG

Heathman Drilling Company, Inc. #2 Abiram
SW NE SW Section 4-105-21W
Graham County, Kansas.

0	90	Shale & sand
90	150	Shale & shells
150	700	Shale & shells
700	760	Sand
760	810	Shale & shells
810	900	Shale & shells
900	950	Sand
950	1275	Shale & shells
1275	1335	Sand
1335	1500	Sand
1500	1774	Shale & shells
1774	1780	Anhydrite
1780	1820	Anhydrite
1820	2030	Shale & shells
2030	2225	Shale & shells
2225	2355	Shale & lime
2355	2465	Shale & lime
2465	2620	Shale & lime
2620	2775	Lime & shale
2775	2915	Shale & lime
2915	3030	Shale & lime
3030	3210	Lime & shale
3210	3300	Shale & lime
3300	3350	Shale & lime
3350	3460	Lime & shale
3460	3532	Lime
3532	3565	Lime
3565	3620	Lime
3620	3657	Lime
3657	3710	Lime
3710	3747	Lime
3747	3769	Lime
3770	3825	Lime
3825	3845	Lime
3845	3851	Conglomerate
3851	3860	Conglomerate
3860	3863	Conglomerate
3863	3895	Conglomerate
3895	3899	Conglomerate
3899	3917	Arbuckle
3917		ROTARY TOTAL DEPTH

COMMENCED: 8/1/50
COMPLETED: 8/13/50

CASING RECORD:

Set 8-5/8" surface casing
at 140' w/100 sacks cement
& 1 CC.

D & A

TOPS:

Heebner	3506	(-1211)	R. B.
Lansing	3546	(-1251)	"
B/KC	3770	(-1475)	"
Cong.	3845	(-1550)	"
Simp.	3884	(-1589)	"
Arb.	3899	(-1604)	"

STATE OF KANSAS)
) SS
COUNTY OF SEDGWICK)

I hereby affirm that the above and foregoing is a true and correct copy of the log of the #2 Abiram located in the SW NE SW of Section 4-105-21W, Graham County, Kansas.

ANSCHUTZ DRILLING CO., INC.

BY: *M. W. Smith*
M. W. Smith

Subscribed and sworn to before me this 15th day of August, 1950.

Leticia Becker
Notary Public

My commission expires January 21, 1954.

PLUGGING
