


WELL PLUGGING RECORD

Give All Information Completely
Make Required Affidavit
Mail or Deliver Report to:
Conservation Division
State Corporation Commission
211 No. Broadway
Wichita, Kansas

NORTH

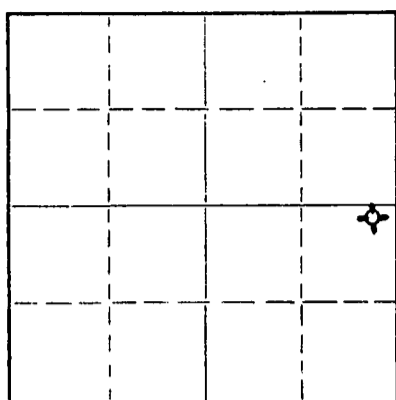

Locate well correctly on above
Section Plat

Rooks County. Sec. 34 Twp 10 Rge. 20W (E) (W)
Location as "NE/CNW&SW&" or footage from lines NE NE SE
Lease Owner D. G. Hansen
Lease Name Veatch Well No. 1
Office Address Logan, Kansas
Character of Well (completed as Oil, Gas or Dry Hole) Dry Hole
Date well completed March 4 19 58
Application for plugging filed March 4 19 58
Application for plugging approved March 4 19 58
Plugging commenced March 4 19 58
Plugging completed March 4 19 58
Reason for abandonment of well or producing formation Too low structurally

If a producing well is abandoned, date of last production _____ 19____
Was permission obtained from the Conservation Division or its agents before plugging was commenced? Yes

Name of Conservation Agent who supervised plugging of this well Eldon Petty, Hays, Kansas
Producing formation _____ Depth to top _____ Bottom _____ Total Depth of Well 3750 Feet
Show depth and thickness of all water, oil and gas formations.

OIL, GAS OR WATER RECORDS

CASING RECORD

FORMATION	CONTENT	FROM	TO	SIZE	PUT IN	PULLED OUT
				8-5/8"	174.33'	none

Describe in detail the manner in which the well was plugged, indicating where the mud fluid was placed and the method or methods used in introducing it into the hole. If cement or other plugs were used, state the character of same and depth placed, from _____ feet to _____ feet for each plug set.

Filled hole with heavy mud to 600'. Set plug. Put in 20 sacks cement. Filled to 200'. Set plug. Put in 15 sacks cement. Filled with heavy mud up to 40'. Set plug. Filled to top with 1/2 sack hulls and 10 sacks cement.

MAR 20 1958 03-20-58

CONSERVATION DIVISION
Wichita, Kansas

(If additional description is necessary, use BACK of this sheet)

Name of Plugging Contractor C-G DRILLING CO.
Address 107 Rule Building, Wichita, Kansas

STATE OF KANSAS, COUNTY OF SEDGWICK, ss.
G. F. Galloway (employee of owner) or (owner or operator) of the above-described well, being first duly sworn on oath, says: That I have knowledge of the facts, statements, and matters herein contained and the log of the above-described well as filed and that the same are true and correct. So help me God.

(Signature) G. F. Galloway
107 Rule Building
(Address)

SUBSCRIBED AND SWORN TO before me this 13th day of March, 1958

My commission expires May 20, 1959
Vicky Jacobs Notary Public.

PLUGGING
FILE NO. 34T 10 R20W
BOOK PAGE 89 LINE 15

CONTRACTOR'S WELL LOG

OPERATOR D. G. Hansen WELL NAME Veatch #1
LOCATION NE NE SE SEC. 34-10-20W RIG NO. 1
COUNTY Rooks STATE Kansas
COMMENCEMENT DATE February 15, 1958 COMPLETION DATE March 4, 1958

LOG OF WELL

Elevation 2135' rotary bushing.
All measurements taken from the top of rotary bushing.

Table with columns: FROM, TO, FORMATION, DEVIATION FROM VERTICAL, REMARKS. Rows include geological data such as Shale, Sand, Shale-Sand, Shale-Shell, Red Bed, Anhydrite, Lime-Shale, and Lime, with depth measurements and deviation angles.

CASING LEFT IN HOLE AFTER COMPLETION

Ran 174.33' (9 jts.) 8-5/8" OD Surface Casing.

STATE OF KANSAS }
COUNTY OF SEDGWICK } SS.

PLUGGING
34 10 R20W
BOOK PAGE 89 LINE 15

The undersigned hereby certifies that to the best of his knowledge and belief, the above facts are true and correct.

C-G DRILLING CO.

By G. F. Galloway

SUBSCRIBED AND SWORN TO BEFORE ME THIS 13th day of March, 1958.

My commission expires:
May 20, 1959

Vicky Jacobs, Notary Public