


Give All Information Completely  
Make Required Affidavit  
Mail or Deliver Report to:  
Conservation Division  
State Corporation Commission  
800 Bitting Building  
Wichita, Kansas

15-163-00988-0000

WELL PLUGGING RECORD

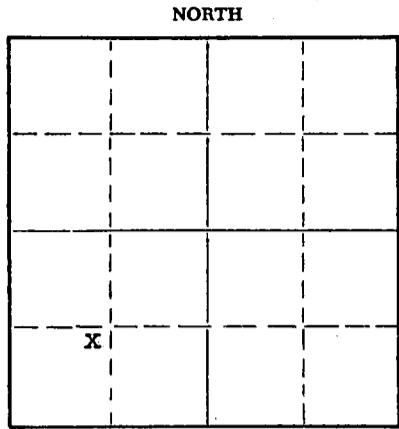

Locate well correctly on above  
Section Plat

Rooks \_\_\_\_\_ County. Sec. 34 Twp. 10S Rge. 20 (E) \_\_\_\_\_ (W) \_\_\_\_\_  
Location as "NE/CNW/SW" or footage from lines NE SW SW  
Lease Owner Barnett Drilling, Inc.  
Lease Name Harlan Well No. 2  
Office Address 409 First National Bank Building, Wichita 2, Kansas  
Character of Well (completed as Oil, Gas or Dry Hole) Dry Hole  
Date well completed June 1 19 56  
Application for plugging filed June 1 19 56  
Application for plugging approved June 1 19 56  
Plugging commenced June 1 19 56  
Plugging completed June 1 19 56  
Reason for abandonment of well or producing formation Dry hole

If a producing well is abandoned, date of last production \_\_\_\_\_ 19 \_\_\_\_\_  
Was permission obtained from the Conservation Division or its agents before plugging was commenced? Yes

Name of Conservation Agent who supervised plugging of this well Eldon Petty  
Producing formation \_\_\_\_\_ Depth to top \_\_\_\_\_ Bottom \_\_\_\_\_ Total Depth of Well 3765 Feet  
Show depth and thickness of all water, oil and gas formations.

OIL, GAS OR WATER RECORDS

CASING RECORD

FORMATION	CONTENT	FROM	TO	SIZE	PUT IN	PULLED OUT

Describe in detail the manner in which the well was plugged, indicating where the mud fluid was placed and the method or methods used in introducing it into the hole. If cement or other plugs were used, state the character of same and depth placed, from \_\_\_\_\_ feet to \_\_\_\_\_ feet for each plug set.

Filled hole with mud to 170 feet. Set plug. Dumped 1/2 sack of hulls and 15 sacks cement on plug. Filled hole with mud to 40 feet. Set plug. Dumped 1/2 sack hulls and 10 sacks cement on plug to fill to bottom of cellar.

(If additional description is necessary, use BACK of this sheet)

Name of Plugging Contractor Barnett Drilling, Inc.  
Address 409 First National Bank Building, Wichita 2, Kansas

STATE OF Kansas, COUNTY OF Sedgwick, ss.  
Jack S. Griggs (employee of owner) or (owner or operator) of the above-described well, being first duly sworn on oath, says: That I have knowledge of the facts, statements, and matters herein contained and the log of the above-described well as filed and that the same are true and correct. So help me God.

(Signature) Jack S. Griggs  
409 First Nat'l Bank Bldg., Wichita, Kansas.  
(Address)

SUBSCRIBED AND SWORN TO before me this 5th day of June, 19 56

My commission expires January 14, 1958

Frances O. Erhard  
**RECEIVED**  
STATE CORPORATION COMMISSION  
Notary Public.

**PLUGGING**  
FILE SEC 34 T 10 R 20W  
BOOK PAGE 67 LINE 33

JUN 11 1956  
CONSERVATION DIVISION  
Wichita, Kansas  
06-06-56

15-163-00988-0000

BARNETT DRILLING, INC.  
LOG OF HARLAN WELL NO. 2  
NE SW SW, SECTION 34-10S-20W  
ROOKS COUNTY, KANSAS

Commenced: 5-22-56

Completed: 6-1-56

<u>Formation</u>	<u>From</u>	<u>To</u>	<u>Remarks</u>
Shale	-0-	85	Set 8-5/8" Casing at 177 Feet; Cemented with 150 sacks.
Sand and Shale	85	150	
Shale and Shells	150	175	
Shale and Shells	175	780	
Sand and Shale	780	860	
Shale and Shells	860	1075	
Sand	1075	1330	
Shale	1330	1600	
Anhydrite	1600	1638	
Shale and Shells	1638	1855	
Shale and Shells	1855	2175	
Shale	2175	2510	
Lime	2510	2590	
Lime and Shale	2590	3330	
Lime	3330	3765	
Total Depth		3765	Dry and Abandoned

CERTIFICATE

I, Jack S. Griggs, of Barnett Drilling, Inc. certify that to the best of my knowledge and belief, that the foregoing is a true and correct log of the Harlan Well No. 2, located in the NE SW SW, of Section 34-10S-20W, Rooks County, Kansas.

Jack S. Griggs

Subscribed and sworn to by and before me in and for the County of Sedgwick, State of Kansas this 5th day of June, 1956.

Frances O. Erhard  
Notary Public

My commission expires January 14, 1958.

**PLUGGING**  
FILE SEC 34 T 10 R 20W  
BOOK PAGE 67 LINE 33