

15-163-03114 -0000


STATE OF KANSAS
STATE CORPORATION COMMISSION

WELL PLUGGING RECORD

Give All Information Completely
Make Required Affidavit
Mail or Deliver Report to:
Conservation Division
State Corporation Commission
211 No. Broadway
Wichita, Kansas

Rooks County. Sec. 34 Twp. 10 Rge. 20 (E) W (W)
Location as "NE/CNW/SW" or footage from lines NE SE NW
Lease Owner C-G Drilling Co. & Oil Trading Associates, Inc.
Lease Name Briggs Well No. 3
Office Address 107 Rule Building, Wichita, Kansas
Character of Well (completed as Oil, Gas or Dry Hole) Dry hole
Date well completed January 8 19 57
Application for plugging filed January 8 19 57
Application for plugging approved January 8 19 57
Plugging commenced January 8 19 57
Plugging completed January 8 19 57
Reason for abandonment of well or producing formation too low structurally

NORTH

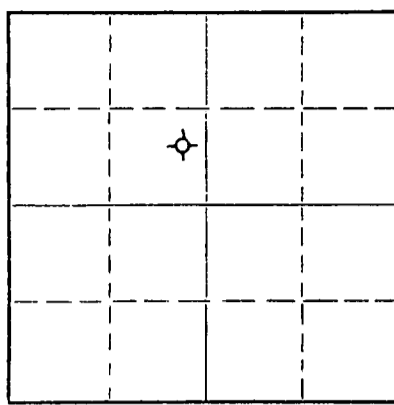

Locate well correctly on above
Section Plat

If a producing well is abandoned, date of last production _____ 19____
Was permission obtained from the Conservation Division or its agents before plugging was commenced? yes

Name of Conservation Agent who supervised plugging of this well Eldon Petty, Hays, Kansas
Producing formation _____ Depth to top _____ Bottom _____ Total Depth of Well 3828 Feet
Show depth and thickness of all water, oil and gas formations.

OIL, GAS OR WATER RECORDS

CASING RECORD

FORMATION	CONTENT	FROM	TO	SIZE	PUT IN	PULLED OUT
				8-5/8"	185'	none

Describe in detail the manner in which the well was plugged, indicating where the mud fluid was placed and the method or methods used in introducing it into the hole. If cement or other plugs were used, state the character of same and depth placed, from _____ feet to _____ feet for each plug set.

Filled hole with heavy mud to 180'. Set plug. Put in 1/2 sack Hulls & 15 sacks cement. Filled with heavy mud to 40' Set plug. Filled to top with 1/2 sack Hulls and 10 sacks cement.

RECEIVED
STATE CORPORATION COMMISSION
CONSERVATION DIVISION
Wichita, Kansas
01-12-57

(If additional description is necessary, use BACK of this sheet)
Name of Plugging Contractor C-G Drilling Co.
Address 107 Rule Building, Wichita, Kansas

STATE OF KANSAS, COUNTY OF SEDGWICK, ss.
Jay H. Galloway (employee of owner) or (owner or operator) of the above-described well, being first duly sworn on oath, says: That I have knowledge of the facts, statements, and matters herein contained and the log of the above-described well as filed and that the same are true and correct. So help me God.

(Signature) Jay H. Galloway
Jay H. Galloway
107 Rule Building
(Address)

SUBSCRIBED AND SWORN TO before me this 10th day of January, 1957

Vicky Jacobs
Vicky Jacobs
Notary Public.

My commission expires May 20, 1959

PLUGGING
FILE SEC 34 T. 10 R. 20W
BOOK PAGE 132 LINE 45

15-163-03114-0000

CONTRACTOR'S WELL LOG

OPERATOR C-G Drilling Co. & Oil Trading Associates, Inc. WELL NAME Briggs #3

LOCATION NE SE NW Sec. 34-10S-20W RIG NO. 1

COUNTY ROOKS STATE Kansas

COMMENCEMENT DATE December 31, 1956 COMPLETION DATE January 8, 1957

LOG OF WELL

Elevation 2128' rotary bushing.
All measurements taken from the top of rotary bushing.

FROM	TO	FORMATION	DEVIATION FROM VERTICAL	REMARKS
0	185	Surface Soil		
185	760	Shale		
760	1085	Shale		
1085	1300	Sand		
1300	1400	Red Bed		
1400	1563	Red Bed		
1563	1603	Anhydrite		
1603	2210	Shale-Lime		
2210	2390	Lime-Shale		
2390	2510	Lime-Shale	0° - 2500	
2510	2810	Lime-Shale	0° - 2750	
2810	2915	Lime-Shale		
2915	3090	Lime-Shale	0° - 3000	
3090	3225	Lime-Shale		
3225	3445	Lime-Shale	0° - 3250	
3445	3575	Lime-Shale	0° - 3500	
3575	3710	Lime-Shale		
3710	3828	Lime-Shale	0° - 3750	

CASING LEFT IN HOLE AFTER COMPLETION

Ran 185' (10 jts.) 8-5/8" OD Surface Casing

STATE OF KANSAS }
COUNTY OF SEDGWICK } ss.

The undersigned hereby certifies that to the best of his knowledge and belief, the above facts are true and correct.

C-G DRILLING CO.

By Jay H. Galloway
Jay H. Galloway

Subscribed and sworn to before me this 10th day of January, 1957.

My commission expires:
May 20, 1959

Vicky Jacobs
Vicky Jacobs, Notary Public

PLUMBING
SEC. 34 10. R 20W
PAGE 182 LINE 45