

Give All Information Completely
Make Required Affidavit
Mail or Deliver Report to:
Conservation Division
State Corporation Commission
800 Bittling Building
Wichita, Kansas

15-163-00858-0000

WELL PLUGGING RECORD

Rooks County. Sec. 34 Twp. 10S Rge. 20W (E) W (W)

Location as "NE/CNWxSWx" or footage from lines NW SW NW

Lease Owner H. E. Alexander

Lease Name Briggs Well No. 1

Office Address Great Bend, Kansas

Character of Well (completed as Oil, Gas or Dry Hole) Dry Hole

Date well completed 4/27 19 55

Application for plugging filed 4-27 19 55

Application for plugging approved 4-27 19 55


Plugging commenced 4-27 19 55

Plugging completed 4-27 19 55

Reason for abandonment of well or producing formation Dry Hole

If a producing well is abandoned, date of last production _____ 19 _____

Was permission obtained from the Conservation Division or its agents before plugging was commenced? yes

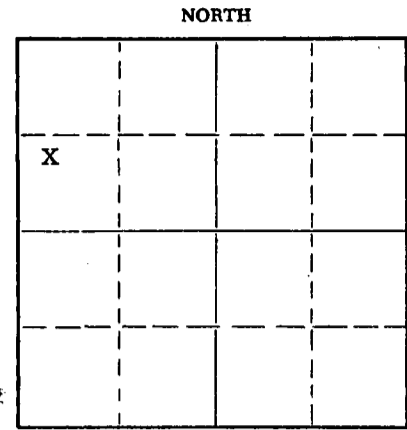

Locate well correctly on above Section Plat

Name of Conservation Agent who supervised plugging of this well Eldon Petty

Producing formation _____ Depth to top _____ Bottom _____ Total Depth of Well 3762 Feet

Show depth and thickness of all water, oil and gas formations.

OIL, GAS OR WATER RECORDS

CASING RECORD

FORMATION	CONTENT	FROM	TO	SIZE	PUT IN	PULLED OUT
				8 5/8	184	0

Describe in detail the manner in which the well was plugged, indicating where the mud fluid was placed and the method or methods used in introducing it into the hole. If cement or other plugs were used, state the character of same and depth placed, from _____ feet to _____ feet for each plug set.

First plug set at 180 ft - 15 sacks cement
Second plug ste at 40 feet - 10 sacks cement

05-03-55
DIVISION
KANSAS

Name of Plugging Contractor Schafer Drilling Co.

Address Box 350, Pratt, Kansas

STATE OF Kansas, COUNTY OF Pratt, ss.

James E. Selby (employee of owner) or (owner or operator) of the above-described well, being first duly sworn on oath, says: That I have knowledge of the facts, statements, and matters herein contained and the log of the above-described well as filed and that the same are true and correct. So help me God.

(Signature) James E. Selby
Pratt, Kansas (Address)

SUBSCRIBED AND SWORN TO before me this 2nd day of May, 19 55

My commission expires 6-20-55 Maudie B McBride Notary Public.

PLUGGING
FILE SEC 34 10 R 20W
BOOK PAGE 115 LINE 41

DRILLERS LOG
BRIGGS #1
ROOKS COUNTY

34-10-20W

0-184	Surface Clay, Shale and Shells
184-770	Gray Shale
770-1050	Shale and Sand
1050-1625	Shale, Sand and Shell
1625-1675	Anhydrite
1675-2020	Shale and Shells
2020-2220	Shale, Shells and Lime
2220-2570	Shale and Lime
2570-3090	Shale and Shells
3090-3315	Shale, Shells and Lime
3315-3365	Lime
3365-3485	Shale and Lime
3485-3700	Lime
3700-3720	Conglomerate
3720-3745	Conglomerate and Shale
3745-3762	Conglomerate and Arbuckle
3762	TOTAL DEPTH

I certify that the above drillers log is true and correct as taken directly from the daily drilling reports of the Briggs #1.

J. Selby
Schafer Drilling Co.

State of Kansas: County of Pratt: SS

The above was subscribed and sworn to before me this 29th day of April, 1955.

Maudie B McBride
Notary Public

My Commission expires June 30, 1955.

RECEIVED
STATE DEPARTMENT OF COMMISSIONS
MAY 7 1955
CONSERVATION DIVISION
Topeka, Kansas

PLUGGING
FILE SEC 34 10 R 20W
BOOK PAGE 115 LINE 41