


WELL PLUGGING RECORD

Give All Information Completely
Make Required Affidavit
Mail or Deliver Report to:
Conservation Division
State Corporation Commission
800 Bittling Building
Wichita, Kansas

NORTH

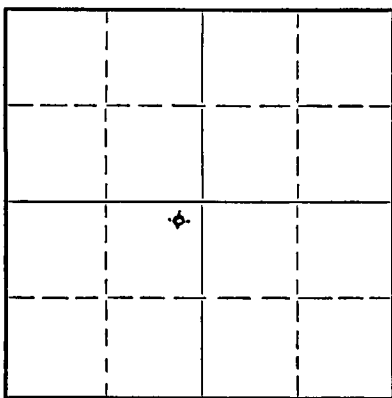

Locate well correctly on above
Section Plat

Graham County. Sec. 3 Twp. 10S Rge. 21W (XX) (W)
Location as "NE/CNW $\frac{1}{4}$ SW $\frac{1}{4}$ " or footage from lines NE $\frac{1}{4}$ NE $\frac{1}{4}$ SW $\frac{1}{4}$
Lease Owner Anderson-Prichard Oil Corp.
Lease Name Miller Well No. 6
Office Address 1000 Apco Tower, Oklahoma City, Oklahoma
Character of Well (completed as Oil, Gas or Dry Hole) dry hole
Date well completed 12-22 1950
Application for plugging filed 12-22 1950
Application for plugging approved 12-22 1950
Plugging commenced 12-22 1950
Plugging completed 12-22 1950

Reason for abandonment of well or producing formation.....
If a producing well is abandoned, date of last production..... 19.....
Was permission obtained from the Conservation Division or its agents before plugging was commenced? yes

Name of Conservation Agent who supervised plugging of this well Eldon Petty
Producing formation..... Depth to top..... Bottom..... Total Depth of Well 3935 Feet
Show depth and thickness of all water, oil and gas formations.

OIL, GAS OR WATER RECORDS

CASING RECORD

Formation	Content	From	To	Size	Put In	Pulled Out
			267'	8-5/8"	269.52'	none

Describe in detail the manner in which the well was plugged, indicating where the mud fluid was placed and the method or methods used in introducing it into the hole. If cement or other plugs were used, state the character of same and depth placed, from.....feet to.....feet for each plug set.

Hole plugged with 15 sacks cement on bottom plug @ 250', 10 sacks on top plug at 40'.

FILED
01-02-51

(If additional description is necessary, use BACK of this sheet)

Correspondence regarding this well should be addressed to Anderson-Prichard Oil Corp.
Address 1000 Apco Tower
Oklahoma City, Oklahoma

STATE OF KANSAS, COUNTY OF SEDGWICK
Richard Hindery, partner of Birmingham-Bartlett Drilling Co. contractor (employed by owner or contractor) of the above-described well, being first duly sworn on oath, says: That I have knowledge of the facts, statements, and matters herein contained and the log of the above-described well as filed and that the same are true and correct. So help me God.

(Signature) Richard Hindery
300 Kaufman Bldg., Wichita, Kansas
(Address)

SUBSCRIBED AND SWORN to before me this 27th day of December 19 50

Lincoln S. Ginger
Notary Public.

My commission expires November 29, 1954.

PLUGGING
FILE SEC 2 T 10 R 10
BOOK PAGE 51 LINE 21

MILLER NO. 6

LOCATION: NE $\frac{1}{4}$ NE $\frac{1}{4}$ SW $\frac{1}{4}$ Sec. 3-10S-21W SPUDDED: 12-10-50
 Graham County, Kansas COMPLETED: 12-22-50

OPERATOR: Anderson-Prichard Oil Corp.

CONTRACTOR: Birmingham-Bartlett Drilling Co.

SURFACE CASING: Ran 12 jts., 269.52' 8-5/8" casing cemented at 267' with 175 sacks bulk cement and 2 c.c.

OIL STRING: N one. D & A.

L O G

(Figures indicate bottom of formation)

0	to	267	Surface
		1040	Shale
		1320	Shale and sand
		1450	Sand
		1750	Shale and red bed
		1759	Red bed
		1802	Anhydrite
		2020	Shale
		2260	Shale and lime
		2330	Shale and shells
		2370	Lime and shale
		2520	Shale
		2780	Shale and lime
		2965	Shale and shells
		3244	Shale
		3335	Shale and lime
		3885	Lime
		3935	Conglomerate
		3935	Total Depth

RECEIVED
BIRMINGHAM-BARTLETT DRILLING CO.
DEC 27 1950

The undersigned Richard Hindery of the Birmingham-Bartlett Drilling Co. certifies that the above is a true and correct log of the formations encountered in drilling the Miller No. 6 well as shown on the daily drilling reports.

BIRMINGHAM-BARTLETT DRILLING CO.

BY Richard Hindery

Subscribed and sworn to before me this 27th day of December, 1950.

Vivian F. Ginger
Notary Public

My commission expires November 29, 1954.

DRILLING
FILE SEC 3 T 10 R 21W
BOOK PAGE 51 LINE 21