


WELL PLUGGING RECORD

Give All Information Completely
Make Required Affidavit
Mail or Deliver Report to:
Conservation Division
State Corporation Commission
800 Blitting Building
Wichita, Kansas

Graham County. Sec. 3 Twp. 10S Rge. 21W (E) (W)
Location as "NE/CNW $\frac{1}{4}$ SW $\frac{1}{4}$ " or footage from lines SW $\frac{1}{4}$ NW $\frac{1}{4}$ SW $\frac{1}{4}$
Lease Owner Anderson-Prichard Oil Corp.
Lease Name Miller Well No. 7
Office Address Great Bend, Kansas
Character of Well (completed as Oil, Gas or Dry Hole) dry hole

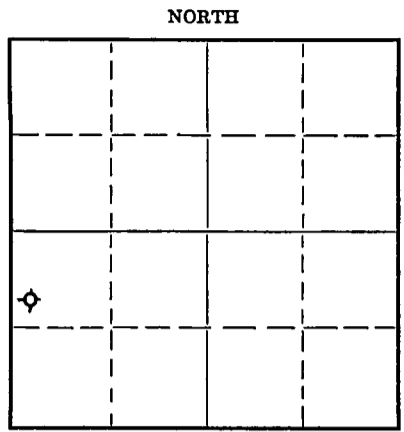

Locate well correctly on above
Section Plat

Date well completed 1-22 1951
Application for plugging filed 1-22 1951
Application for plugging approved 1-22 1951
Plugging commenced 1-22 1951
Plugging completed 1-22 1951
Reason for abandonment of well or producing formation _____

If a producing well is abandoned, date of last production _____ 19____
Was permission obtained from the Conservation Division or its agents before plugging was commenced? yes
Name of Conservation Agent who supervised plugging of this well Eldon Petty
Producing formation _____ Depth to top _____ Bottom _____ Total Depth of Well 3889 Feet
Show depth and thickness of all water, oil and gas formations.

OIL, GAS OR WATER RECORDS

CASING RECORD

Formation	Content	From	To	Size	Put In	Pulled Out
	Surface Casings:	8-5/8"	28.55#	casing cemented at 237'		
			with 175 sacks	cement & 2 c.c.		

Describe in detail the manner in which the well was plugged, indicating where the mud fluid was placed and the method or methods used in introducing it into the hole. If cement or other plugs were used, state the character of same and depth placed, from _____ feet to _____ feet for each plug set.

Plugged hole with bottom set @ 210', 15 sacks cement
one sack hulls, top plug @ 40' 1/2 sack hulls and
10 sacks cement.

RECEIVED
STATE CORPORATION COMMISSION
JAN 29 1951
CONSERVATION DIVISION
Wichita, Kansas

(If additional description is necessary, use BACK of this sheet)
Correspondence regarding this well should be addressed to Anderson-Prichard Oil Corporation
Address West Tenth Street
Great Bend, Kansas

STATE OF KANSAS, COUNTY OF SEDEWICK
Richard Hindery, partner of Birmingham- Bartlett Drig. Co. contractor of the above-described well,
being first duly sworn on oath, says: That I have knowledge of the facts, statements, and matters herein contained and the log of the above-described well as filed and that the same are true and correct. So help me God.

(Signature) Richard Hindery
300 Kaufman Bldg., Wichita 2, Kansas
(Address)

SUBSCRIBED AND SWORN to before me this 24th day of January 1951.
Lincoln J. Ginger
Notary Public.

My commission expires Nov. 23, 1954
My commission expires _____

PLUGGING
FILE SEC 3 T 10 R 07
BOOK PAGE 56 LINE 4

MILLER NO. 7

LOCATION: SW $\frac{1}{4}$ NW $\frac{1}{4}$ SW $\frac{1}{4}$ Sec. 3-10S-21W SPUDDED: 1-10-51
 Graham County, Kansas
 OPERATOR: Anderson-Prichard Oil Corp. COMPLETED: 1-22-51
 CONTRACTOR: Birmingham-Bartlett Drilling Co.
 SURFACE CASING: Ran 11 jts., 238.90' 8-5/8" 28.55#
 casing cemented at 237' with 175 sacks
 cement and 2 c.c.
 OIL STRING: None. D & A.

L O G

(Figures indicate bottom of formation)

0 to 40	Surface
237	Shale and shells
730	Shale
1230	Shale and sand
1490	Dk. Sand
1500	Shale
1753	Shale and red bed
1790	Anhydrite
1890	Shale
2175	Shale and shells
2500	Shale
2865	Shale and lime
3105	Shale
3215	Shale and shells
3340	Shale and lime
3400	Lime
3465	Lime and shale
3849	Lime
3859	Conglomerate
3889	Lime
3889	T. D.

The undersigned Richard Hindery of the Birmingham-Bartlett Drilling Co. hereby certifies that the above is a true and correct log of the formations encountered in drilling the Miller No. 7 well as shown on the daily drilling reports.

BIRMINGHAM-BARTLETT DRILLING CO.

BY Richard Hindery

Subscribed and sworn before me this 24th day of January, 1951.

William J. Singer
Notary Public

My commission expires November 29, 1954.

PLUGGING
FILE SEC 3 T10 R1W
BOOK PAGE 58 OF 4