

15-065-01681-0000

Original - State Corp. Comm.
Copy - File
Copy - Von Roe - 343 FPB
Copy - Oklahoma City Office


FORM CP-4

STATE OF KANSAS
STATE CORPORATION COMMISSION
CONSERVATION DIVISION
P. O. BOX 17077
WICHITA, KANSAS 67217

WELL PLUGGING RECORD

Graham County. Sec. 3 Twp. 10S Rge. 21W (W)
Location as "NE/CNW/SW" or footage from lines 330' FSL 330' FEI SE/4
Lease Owner Phillips Petroleum Company
Lease Name Morel Well No. # 1
Office Address Box 287, Great Bend, Kansas
Character of Well (completed as Oil, Gas or Dry Hole) Oil
Date well completed September 28 19 50
Application for plugging filed July 17 19 74
Application for plugging approved July 23 19 74
Plugging commenced November 18 19 74
Plugging completed November 26 19 74
Reason for abandonment of well or producing formation Depleted

NORTH

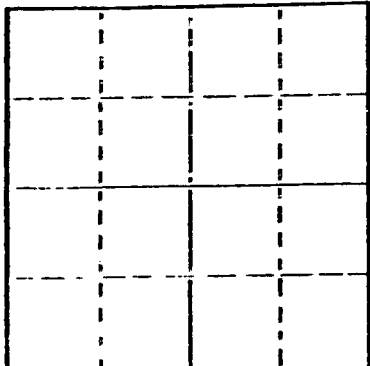

Locate well correctly on above Section Plat

If a producing well is abandoned, date of last production August 20 19 63
Was permission obtained from the Conservation Division or its agents before plugging was commenced? Yes

Name of Conservation Agent who supervised plugging of this well W. L. Nichol
Producing formation Arbuckle Depth to top 3858 Bottom 3865 Total Depth of Well 3865 Feet
Show depth and thickness of all water, oil and gas formations.

OIL, GAS OR WATER RECORDS

CASING RECORD

FORMATION	CONTENT	FROM	TO	SIZE	PUT IN	PULLED OUT
Arbuckle	Oil & Water	3858	3865	5 1/2"	3883'	2636'
				8 5/8"	1838'	0'

Describe in detail the manner in which the well was plugged, indicating where the mud fluid was placed and the method or methods used in introducing it into the hole. If cement or other plugs were used, state the character of same and depth placed, from _____ feet to _____ feet for each plug set.

On 11-20-74 Knight CPU MI to P&A SD oilwell. Dmpd sand to 3840', 5 sx. cmt. 3840' to 3797'. Shot 5 1/2" csg. @2903', 2805', 2705'. Pulled total 79 jts. (2636') 5 1/2" OD 14# 8R SS j-55 csg. Allied cmtg. Inc. pmpd 1 sx hulls, 12 sx gel, 150CF Reg. Pozmix cmt, 5 sx gel, 10 CF reg Pozmix cmt from 1450' to btm. cellar. 700# MP, 300# SIP. Well P&A 2:30 PM 11-26-74.

(If additional description is necessary, use BACK of this sheet)

Name of Plugging Contractor Knight Casing Pulling Co. Inc.
Address Box 405, Chase, Kansas

STATE OF Kansas COUNTY OF Barton, ss.
C. D. Dohrer (employee of owner) or (owner or operator) of the above-described well.


being first duly sworn on oath, says: That I have knowledge of the facts, statements, and matters herein contained and the log of the above-described well as filed and that the same are true and correct. So help me God.

(Signature) C. D. Dohrer Area Supt.
Box 287, Great Bend, Kansas 67530 (Address)

RECORDED AND SWORN TO before me this 20th day of December, 19 74

My commission expires May 6, 1978

Betty M. Clarke Notary Public.

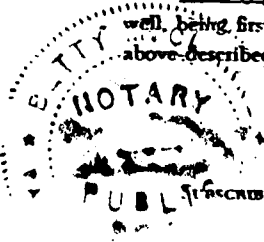

RECEIVED
STATE CORPORATION COMMISSION
DEC 27 1974
CONSERVATION DIVISION

15-065-01681-0000

Form No. 575

Formation Record

Lease

Word

Well No.

1

FROM	TO	Formation	REMARKS
0	750	Shale and Shells	11' thick:
750	900	Sand	
900	1000	Shale and Shells	
1000	1500	Shale and Sand	
1200	1685	Shale and Shells	
1685	1763	Redbed - Shells	
1763	1825	Anhydrite	Top Anhydrite: 1769' Bottom: 1825'
1825	2100	Shale and Shells	
2100	2200	Shale and Salt	
2200	3495	Lime and Shale	Tops: Howard: 3299' Topeka: 3326' Hoebner: 3508' Toronto: 3530' D.K.C.: 3547'
3495	3865	Lime	Penn. Cong.: 3830' Arbuckle: 3858'

RECEIVED
 STATE CORPORATION COMMISSION
 JUL 23 1914
 CONSERVATION DIVISION
 Wichita, Kansas