


STATE OF KANSAS
STATE CORPORATION COMMISSION

Give All Information Completely
Make Required Affidavit
Mail or Deliver Report to:
Conservation Division
State Corporation Commission
800 Bittling Building
Wichita, Kansas

WELL PLUGGING RECORD

NORTH

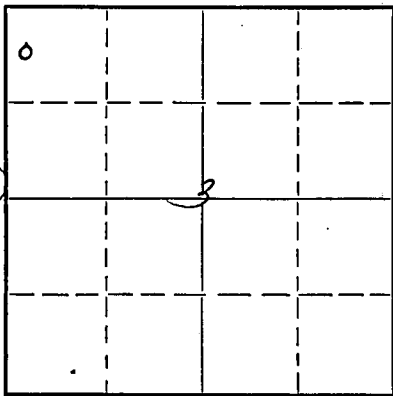

Locate well correctly on above
Section Plat

Graham County. Sec. 3 Twp. 10S. Rge. 21 (W)
Location as "NE/CNW $\frac{1}{4}$ SW $\frac{1}{4}$ " or footage from lines C. W/2 NW/4 NW/4
Lease Owner Heathman & Co.
Lease Name RUDMAN Well No. 2
Office Address 509 Orpheum Building, Wichita, Kansas
Character of Well (completed as Oil, Gas or Dry Hole) Dry hole
Date well completed 1-6 19 52
Application for plugging filed 1-6 19 52
Application for plugging approved 1-6 19 52
Plugging commenced 1-6 19 52
Plugging completed 1-6 19 52
Reason for abandonment of well or producing formation Dry hole
If a producing well is abandoned, date of last production 19
Was permission obtained from the Conservation Division or its agents before plugging was commenced? YES

Name of Conservation Agent who supervised plugging of this well Eldon Petty, Box 326, Hays, Kansas
Producing formation Depth to top Bottom Total Depth of Well 390 Feet
Show depth and thickness of all water, oil and gas formations.

OIL, GAS OR WATER RECORDS

CASING RECORD

Formation	Content	From	To	Size	Put In	Pulled Out
None				8-5/8" (167')	set @ 163'	
				w/100 sacks cement and		
				1 sack C.C.		
					None pulled	

Describe in detail the manner in which the well was plugged, indicating where the mud fluid was placed and the method or methods used in introducing it into the hole. If cement or other plugs were used, state the character of same and depth placed, from feet to feet for each plug set.

Filled hole with heavy mud; set first plug
at 150' cemented with 15 sacks; set top plug
40' down and cemented with 10 sacks cement.

(If additional description is necessary, use BACK of this sheet)

Correspondence regarding this well should be addressed to Heathman & Co.
Address 509 Orpheum Building, Wichita, Kansas

STATE OF KANSAS, COUNTY OF SEDGWICK, ss.
H. D. Shreve (employed as owner) of the above-described well,
being first duly sworn on oath, says: That I have knowledge of the facts, statements, and matters herein contained and the log of the above-described well as filed and that the same are true and correct. So help me God.

(Signature) [Signature]
509 Orpheum Building, Wichita, Kansas
(Address)

SUBSCRIBED AND SWORN to before me this 10th day of January, 19 52.

My commission expires June, 28, 1952

My commission expires

23-5091-s 8-50-10M

PLUGGING
FILE SEC 3 T 10 R 21
BOOK PAGE 134 LINE 17

[Signature] Notary Public.

JAN 11 1952 01-11-52

RUDMAN WELL NO. 2

Location: C. W/2 NW/4 NW/4 Sec. 3-10S-21W
Graham County, Kansas

Operator: Heathman & Co.

Contractor: Heathman & Co.

Surface Casing: 8-5/8" (167') set @ 163'
w/100 sacks cement and
1 sack C.C.

Oil String: None - D & A

Date Spudded: 12-26-51

Rotary Completed: 1-6-52

Elevation: 2295' Gr; 2297' DF
2299' KB

Rotary Total Depth: 3904'

GEOLOGICAL TOPS (KB)

Anhydrite	1769 (+ 530)
Heebner	3510 (-1211)
Lansing-Kansas City	3550 (-1251)
Base of Kansas City	3769 (-1470)
Marmaton Chert	3828 (-1529)
Simpson	3871 (-1572)
Arbuckle	3885 (-1586)
Rotary Total Depth	3904 (-1605)

L O G

(Figures indicate bottom of formation)

Shale and sand	0 to 830
Sand	1185
Sand and shale	1260
Sand	1510
Shale and shells	1769
Anhydrite	1808
Shale and shells	2625
Lime and shale	2790
Shale and lime	3312
Lime	3389
Lime and shale	3469
Shale and lime	3582
Lime and shale	3773
Shale and lime	3889
Lime and chert	3897
Shale and lime	3904
Total Depth	3904

The undersigned, H. D. Shreve, hereby certifies that the above log is a true and correct log of the formations encountered in drilling the above noted well as reflected by the Daily Drilling Reports.


HEATHMAN & CO.

By



Partner

Subscribed and sworn to
before me this 9th day of
January 1952.

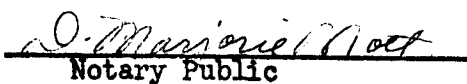
Notary Public

My commission expires: My commission expires 1-1-53

