

API NUMBER 15-065-01685-0000

LEASE NAME Morel

WELL NUMBER 6

1650 Ft. from S Section Line

1650 Ft. from E Section Line

SEC. 3 TWP. 10s RGE. 21w (E) or (W)

COUNTY Graham

Date Well Completed 12/22/51

Plugging Commenced 09/29/93

Plugging Completed 10/02/93

TYPE OR PRINT  
 NOTICE: Fill out completely  
 and return to Cons. Div.  
 office within 30 days.

LEASE OPERATOR Phillips Petroleum Company

ADDRESS Route 3, Box 20A, Great Bend, Kansas 67530

PHONE# (316) 793-8421 OPERATORS LICENSE NO. 5229

Character of Well oil

(Oil, Gas, D&A, SWD, Input, Water Supply Well)

The plugging proposal was approved on June 4, 1993 (date)

by David P. Williams, Production Supervisor (KCC District Agent's Name).

Is ACO-1 filed? no if not, is well log attached? yes

Producing Formation LKC Depth to Top 3554 Bottom 3756 T.D. 3880

Show depth and thickness of all water, oil and gas formations.

OIL, GAS OR WATER RECORDS | CASING RECORD

Formation	Content	From	To	Size	Put In	Pulled out
Topoka		3333'		8 5/8"	341'	0
Toronoto		3537'		5 1/2"	3874'	0
Lansing-Kansas City		3554'				
Arbuckle		3874'				

Describe in detail the manner in which the well was plugged, indicating where the mud fluid was placed and the method or methods used in introducing it into the hole. If cement or other plug were used, state the character of same and depth placed, from feet to feet each set GIH w/wireline, tagged @ 3808'. 5' of fillup in well. RU to 8 5/8" x 5 1/2" annulus. Mixed & propd 15 sx 65/35 pozmix cnt w/10% gel @ 325# pressure, 300# SIP. RU to 5 1/2" csq. Mixed & propd 235 sx 65/35 pozmix cnt w/10% gel. Added 500# hulls to first 50 sx @ 300# press, 50# SIP. DSS

RECEIVED  
 STATE CORPORATION COMMISSION

Name of Plugging Contractor Phillips Petroleum Company License No. 5229

Address Route 3, Box 20A, Great Bend, Kansas 67530

CONSERVATION DIVISION  
 Wichita, Kansas

NAME OF PARTY RESPONSIBLE FOR PLUGGING FEES: Phillips Petroleum Company

STATE OF Kansas COUNTY OF Rooks, ss.

L.G. Janson, Jr., Great Bend Area Superintendent


(Employee of Operator) or (Operator) of above-described well, being first duly sworn on oath, says: That I have knowledge of the facts statements, and matters herein contained and the log of the above-described well as filed the the same are true and correct, so help me God.

(Signature) [Signature]  
 (Address) \_\_\_\_\_

SUBSCRIBED AND SWORN TO before me this 22nd day of October, 19 93

Carla M. Yahrne  
 Notary Public

My Commission Expires: 10-23-96  
 USE ONLY ONE SIDE OF EACH FORM

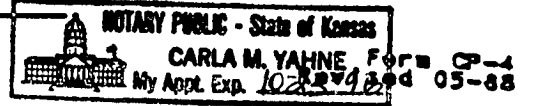


WELLBORE SCHEMATIC

Well Name: Morel Well No. 6  
 Location: SE NW SE Section 3, T10S - R21W  
 County/St: Graham County, Kansas  
 Field: Morel  
 Spud: 10/11/51 Completed: 12/22/51 IP: 240 BOPD & 0 BWPD

GL 2301'  
 KB 2305'  
 PBTD 3813'  
 TD 3880'

Formation Tops:

Anhydrite 1777'  
 Howard 3308'  
 Topeka 3333'  
 Heebner 3516'  
 Toronto 3537'  
 Lansing-Kansas City 3554'  
 Arbuckle 3874'

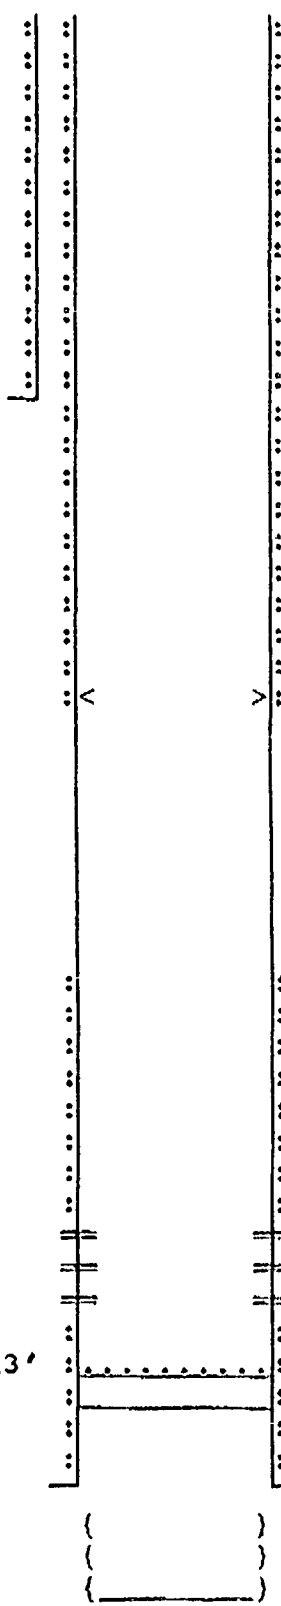

8-5/8" 24#  
 @ 341' w/ 350 sx.

< 1794' Baker Model 'F'  
 > Collar w/ 550 sx.

: TOC 1st Stage  
 : Unknown

: LKC Perfs:  
 == 3597'-601' (C) 12/90  
 == 3642'-46' (F) 12/90  
 == 3749'-56' (K) 12/90

PBTD 3813' : ..... : 3820' CIBP w/  
 12/90 : : 1 sk cmt on top

: 5-1/2" 14#  
 : @ 3874' w/ 150 sx.

{ } Arbuckle O.H.  
 { } 3874'-80'

TD 3880'

Prepared By: J. Arroyo  
 Date: 03/29/93

RECEIVED  
 STATE CORPORATION COMMISSION  
 JUN 4 1993  
 CONSERVATION DIVISION  
 Wichita, Kansas