


STATE OF KANSAS
STATE CORPORATION COMMISSION
Give All Information Completely
Make Required Affidavit
Mail or Deliver Report to:
Conservation Division
State Corporation Commission
211 No. Broadway
Wichita, Kansas

WELL PLUGGING RECORD

Graham County. Sec. 3 Twp. 10S Rge. 21 ~~(R)~~ (W)
Location as "NE/CNW/SW" or footage from lines NE SE SW
Lease Owner Union Texas Petroleum, Inc.
Lease Name C. L. Miller Well No. 4
Office Address Drawer D, Great Bend, Kansas
Character of Well (completed as Oil, Gas or Dry Hole) oil
Date well completed December 21, 1950
Application for plugging filed April 28, 1964
Application for plugging approved April 29, 1964
Plugging commenced June 2, 1964
Plugging completed June 13, 1964
Reason for abandonment of well or producing formation Dry

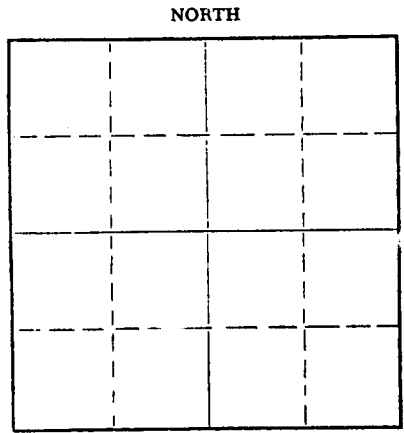

Locate well correctly on above Section Plat

If a producing well is abandoned, date of last production February 14, 1964
Was permission obtained from the Conservation Division or its agents before plugging was commenced? Yes

Name of Conservation Agent who supervised plugging of this well W. L. Nichols
Producing formation K. C. Depth to top 3534' Bottom 3745' Total Depth of Well 3852 Feet
Show depth and thickness of all water, oil and gas formations.

OIL, GAS OR WATER RECORDS

CASING RECORD

FORMATION	CONTENT	FROM	TO	SIZE	PUT IN	PULLED OUT
				8 5/8	265	None
				5 1/2	None	249
					3852	

Describe in detail the manner in which the well was plugged, indicating where the mud fluid was placed and the method or methods used in introducing it into the hole. If cement or other plugs were used, state the character of same and depth placed, from _____ feet to _____ feet for each plug set.

Cleaned out cellar.

Shot pipe at 600', 500', 400' and 270'.

Cut off head; shot pipe at 250'. Build rock bridge.
Dumped 20 sacks of cement.

Filled hole with mud. Build rock bridge. Capped well with 10 sacks of cement.

RECEIVED
STATE CORPORATION COMMISSION

JUN 18 1964

CONSERVATION DIVISION
Wichita, Kansas

(If additional description is necessary, use BACK of this sheet)

Name of Plugging Contractor Forbes Casing Pulling, Inc.
Address P. O. Box 221, Great Bend, Kansas

STATE OF Kansas, COUNTY OF Barton, ss.
Harold Rosenberg (employee of owner) or (~~owner or operator~~) of the above-described well, being first duly sworn on oath, says: That I have knowledge of the facts, statements, and matters herein contained and the log of the above-described well as filed and that the same are true and correct. So help me God.

(Signature) Harold Rosenberg UNION TEXAS PETROLEUM INC.
Drawer D, Great Bend, Kansas
(Address)

SUBSCRIBED AND SWORN TO before me this 17th day of June, 1964

Esther L. Koch
Notary Public.

My commission expires Feb. 7, 1966



MILLER NO. 4 WELL

LOCATION: NE 1/4 SE 1/4 SW 1/4 Sec. 3-108-21W
Graham County, Kansas

OPERATOR: Anderson-Fruehard Oil Corporation

CONTRACTOR: Birmingham-Bartlett Drilling Co.

SURFACE CASING: Ran 12 jts., 266' 8-5/8" casing cemented
@ 265' with 175 sacks bulk cement and 2 c.c.

OIL STRING: Ran 120 jts. 5 1/2" 11# J-55 set at 3851.5' with
125 sacks bulk cement.

SPUDDED: 11-15-50
COMPLETED: 11-25-50

L O G

(Figures indicate bottom of formation)

0 to 265	Surface
910	Shale
1265	Shale and sand
1485	Sand
1778	Shale and red bed
1815	Anhydrite
1910	Shale and shells
2215	Shale
2840	Shale and lime
3165	Shale and shells
3200	Shale
3355	Shale and lime
3852	Lime
3852	Total Depth.

RECEIVED
STATE CORPORATION COMMISSION
APR 30 1964
CONSERVATION DIVISION
Wichita, Kansas

The undersigned Richard Hindery of the Birmingham-Bartlett Drilling Co. hereby certifies that the above is a true and correct log of the formations encountered in the drilling of the Miller #4 well as shown on the daily drilling reports.

BIRMINGHAM-BARTLETT DRILLING CO.

BY Richard Hindery

Subscribed and sworn before me this 28th day of November, 1950.

Virgil F. Vinger
Notary Public

My commission expires November 29, 1950.