

STATE OF KANSAS
STATE CORPORATION COMMISSION

Form CP-4

Give All Information Completely
Make Required Affidavit
Mail or Deliver Report to:
Conservation Division
State Corporation Commission
212 No. Market
Wichita, Kansas 67202

WELL PLUGGING RECORD

Graham County, Sec. 23 Twp. 10 Rge. 21 (E) W (W)

Location as "NE/CNW/SW" or footage from lines NE SW NW

Lease Owner Palomino Petroleum

Lease Name Lewis Well No. # 3

Office Address 304 Insurance Bldg.; Wichita, Ks, 67202

Character of Well (completed as Oil, Gas or Dry Hole) oil well

Date well completed August 25 1954

Application for plugging filed November 1971

Application for plugging approved November 1971


Plugging commenced December 24 1971

Plugging completed December 24 1971

Reason for abandonment of well or producing formation Non-commercial

If a producing well is abandoned, date of last production October 9 1970

Was permission obtained from the Conservation Division or its agents before plugging was commenced? Yes

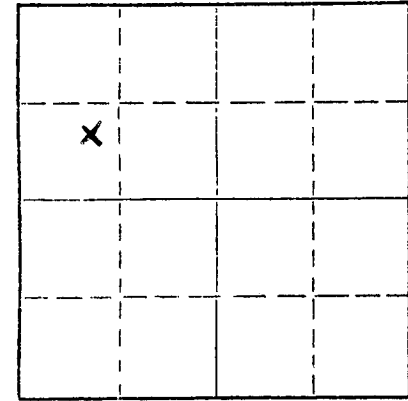

Locate well correctly on above Section Plat

Name of Conservation Agent who supervised plugging of this well Bill Nichols

Producing formation Arbuckle Depth to top 3727 Bottom 3732 Total Depth of Well 3732 Feet

Show depth and thickness of all water, oil and gas formations.

OIL, GAS OR WATER RECORDS

CASING RECORD

FORMATION	CONTENT	FROM	TO	SIZE	PUT IN	PULLED OUT
				8 5/8"	227 226	None
				5 1/2"	3728	None

Describe in detail the manner in which the well was plugged, indicating where the mud fluid was placed and the method or methods used in introducing it into the hole. If cement or other plugs were used, state the character of same and depth placed, from _____ feet to _____ feet for each plug set.

December 24, 1971 Allied Cementing Co. mixed and pumped down 5 1/2" casing, 2 sx hulls, 30 sx cement, 27 sx gel and 125 sx cement.
5 1/2" casing had been cemented in.

RECEIVED
STATE CORPORATION COMMISSION
JAN 3 1972
CONSERVATION DIVISION
Wichita, Kansas

(If additional description is necessary, use BACK of this sheet)


Name of Plugging Contractor RUSS CASING PULLING, INC.
Address P. O. BOX 1082 GREAT BEND, KANSAS 67530

STATE OF Kansas, COUNTY OF Sedgwick, ss.
R. W. Watchous (owner or operator) of the above-described

well, being first duly sworn on oath, says: That I have knowledge of the facts, statements, and matters herein contained and the log of the well described well as filed and that the same are true and correct. So help me God.

(Signature) R. W. Watchous
304 Insurance Bldg. Wichita, Ks.
(Address)

Subscribed and sworn to before me this 30th day of December, 1971

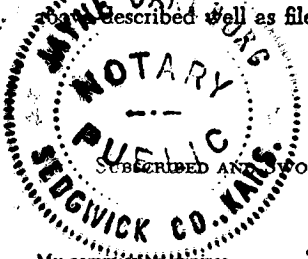

Jayne Carlburg
Notary Public.

My commission expires September 22, 1975

DRILLERS' LOG

Company: The Berby Oil Company
Farm Name: Lewis "A" Well No. 3

0 NE/4 SW/4 NW/4
Sec. 23, Twp. 19S, Rge 21W,
County: Graham,
Kansas

Total Depth: 3729'

Elevation:

Comm: 8-11-54 Comp: 8-20-54
Contractor: Glenn W. Peal

Production:

Casing: 8 5/8" 226' con.
5 1/2" 3728' con.

Figures below indicate thickness of formations:

Shale	0 -	230
Shale and sand		1620
Anhydrite		2070
Shale and shells		2150
Shale and Lime		2210
Lined shale		2360
Lime		2510
Shale and Lime		2850
Lime		3080
Shale and Lime		3220
Lime		3729
Total Depth		3729

RECEIVED
STATE CORPORATION COMMISSION
NOV 29 1971
CONSERVATION DIVISION
Wichita, Kansas

This is to certify that the above information is to the best of our knowledge, true and correct.

GLENN W. PEAL

By: Glenn W. Peal

SUBSCRIBED AND SWORN to before me this 23rd day of August, 1954.

My commission expires: June 4, 1955

Marion M. Herbert
Notary Public

D.V. tool @ 1618' and cemented to surface w/ 485 sacks.