

15-065-00425-0000


STATE OF KANSAS  
STATE CORPORATION COMMISSION

WELL PLUGGING RECORD

Give All Information Completely  
Make Required Affidavit  
Mail or Deliver Report to:  
Conservation Division  
State Corporation Commission  
800 Biting Building  
Wichita, Kansas

Graham County. Sec. 23 Twp. 10 Rge. 21 (E) W (W)  
Location as "NE/CNW/SW" or footage from lines W/2 W/2 SW  
Lease Owner Trans Era Petroleum, Inc.  
Lease Name Noah Well No. 1  
Office Address Russell, Kansas  
Character of Well (completed as Oil, Gas or Dry Hole) Dry  
Date well completed 2/12/54 19  
Application for plugging filed 2/11/54 19  
Application for plugging approved 2/11/54 19  
Plugging commenced 2/12/54 19  
Plugging completed 2/12/54 19  
Reason for abandonment of well or producing formation Dry

NORTH

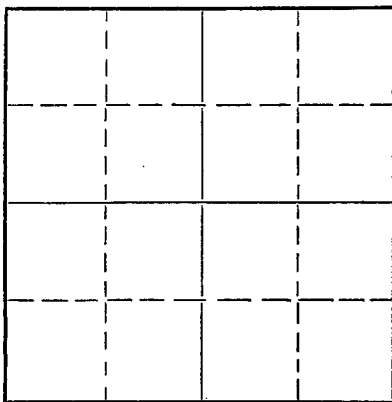

Locate well correctly on above  
Section Plat

If a producing well is abandoned, date of last production \_\_\_\_\_ 19\_\_\_\_  
Was permission obtained from the Conservation Division or its agents before plugging was com-  
menced? Yes

Name of Conservation Agent who supervised plugging of this well Eldon Petty  
Producing formation \_\_\_\_\_ Depth to top \_\_\_\_\_ Bottom \_\_\_\_\_ Total Depth of Well 3857 Feet  
Show depth and thickness of all water, oil and gas formations.

OIL, GAS OR WATER RECORDS

CASING RECORD

FORMATION	CONTENT	FROM	TO	SIZE	PUT IN	PULLED OUT
				8 5/8"	201'	None

Describe in detail the manner in which the well was plugged, indicating where the mud fluid was placed and the method or methods used in introducing it into the hole. If cement or other plugs were used, state the character of same and depth placed, from \_\_\_\_\_ feet to \_\_\_\_\_ feet for each plug set.

PLUGGING RECORD

Finished laying down drill pipe. Filled hole with heavy mud to 180', set bottom plug at 180', 15 sacks of cement and 1/2 sack of hulls were used. Filled hole with mud to 40', set top plug at 40' with 1/2 sack of hulls and 10 sacks of cement.

02-24-54  
FILED  
FEB 24 1954  
COUNTY OF RUSSELL  
KANSAS


(If additional description is necessary, use BACK of this sheet)

Name of Plugging Contractor \_\_\_\_\_  
Address \_\_\_\_\_

STATE OF KANSAS, COUNTY OF RUSSELL, ss.  
H. R. Michaelis (employee of owner) or (owner or operator) of the above-described well, being first duly sworn on oath, says: That I have knowledge of the facts, statements, and matters herein contained and the log of the above-described well as filed and that the same are true and correct. So help me God.

(Signature) H. R. Michaelis  
Russell, Kansas  
(Address)

SUBSCRIBED AND SWORN to before me this 23rd day of February, 19 54  
Margie Cooper  
Notary Public.

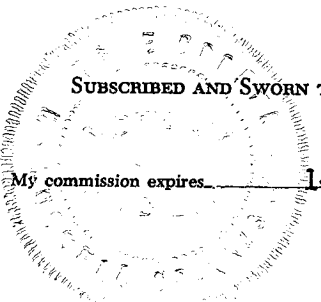

PLUGGING  
FILE SEC 23 T 10 R 210  
BOOK 14 LINE 24

15-065-00425-0000

Trans Era Petroleum, Inc.  
Noah #1

W/2 W/2 SW 23-10-21  
Graham County, Kansas

Total Depth: 3357'  
Comm. 1/28/54  
Comp. 2/12/54

Casing

Cement

3 5/8" Set @ 201'

135 sacks of Victor

Formation	Depth
Surface sand-shale	200
Shale	645
Sand	945
Shale-shells	1160
Sand	1335
Red bed	1650
Anhydrite	1696
Red bed-shale	1772
Shale-shells	2020
Shale-salt	2135
Lime-shale	3260
Lime	3305
Lime-shale	3389
Lime	3682
Lime-shale	3760
Lime-shale-chert	3762
Conglomerate	3781
Lime-shale	3789
Chert-conglomerate	3832
Arbuckle	3357'

STATE OF KANSAS )  
                          ) ss  
RUSSELL COUNTY )

I hereby certify that the above information is true and correct to the best of my knowledge.

\_\_\_\_\_ *W. B. F.*

Subscribed and sworn to before me this 23rd day of February, 1954.

\_\_\_\_\_ *W. B. F.*  
Notary Public

My commission expires: 1-30-57.

FILED  
FEB 23 1954  
Graham County, Kansas