

15-065-01761-0000


STATE OF KANSAS  
STATE CORPORATION COMMISSION

WELL PLUGGING RECORD

Give All Information Completely  
Make Required Affidavit  
Mail or Deliver Report to:  
Conservation Division  
State Corporation Commission  
800 Bitting Building  
Wichita, Kansas

Graham County. Sec. 23 Twp. 10 Rge. 21 ~~(W)~~ (W)  
Location as "NE/CNW%SW%" or footage from lines NW SW NE  
Lease Owner Anderson-Prichard Oil Corporation  
Lease Name Pierce Well No. 1  
Office Address Box 112, Great Bend, Kansas  
Character of Well (completed as Oil, Gas or Dry Hole) Oil  
Date well completed September 6 19 53  
Application for plugging filed August 17 19 53  
Application for plugging approved August 19 19 53  
Plugging commenced September 2, 19 53  
Plugging completed September 6 19 53  
Reason for abandonment of well or producing formation Non-commercial  
Making 100% water  
If a producing well is abandoned, date of last production August 19 52  
Was permission obtained from the Conservation Division or its agents before plugging was commenced? Yes

NORTH

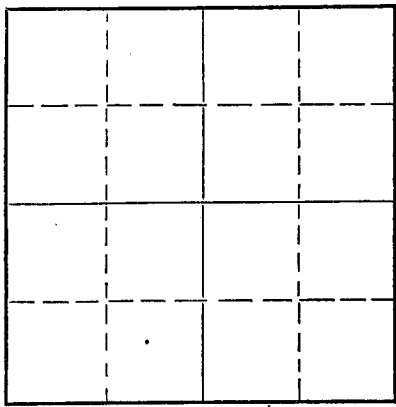

Locate well correctly on above  
Section Plat

Name of Conservation Agent who supervised plugging of this well Mr. Eldon Petty  
Producing formation Arbuckle Depth to top 3754 Bottom \_\_\_\_\_ Total Depth of Well 3760 Feet  
Show depth and thickness of all water, oil and gas formations.

OIL, GAS OR WATER RECORDS

CASING RECORD

FORMATION	CONTENT	FROM	TO	SIZE	PUT IN	PULLED OUT
				8-5/8	277'	None
				5-1/2	3755'	3065'

Describe in detail the manner in which the well was plugged, indicating where the mud fluid was placed and the method or methods used in introducing it into the hole. If cement or other plugs were used, state the character of same and depth placed, from \_\_\_\_\_ feet to \_\_\_\_\_ feet for each plug set.

Plugged back from 3760 to 3634' with crushed rock and 5 sax cement  
Shot casing off @ 3065' - Pulled casing  
Squeezed surface piep with 30 sax Howco Jell and 100 sax bulk cement

09-19-53  
RECEIVED  
SEP 19 1953  
CONSERVATION DIVISION  
Wichita, Kansas


(If additional description is necessary, use BACK of this sheet)  
Name of Plugging Contractor Forbes Casing Pulling Company  
Address P. O. Box 221 - Great Bend, Kansas

STATE OF KANSAS, COUNTY OF BARTON, ss.  
Gerald M. Dougherty (employee of owner) or (owner or operator) of the above-described well, being first duly sworn on oath, says: That I have knowledge of the facts, statements, and matters herein contained and the log of the above-described well as filed and that the same are true and correct. So help me God.

(Signature) Gerald M. Dougherty  
Box 142 - Great Bend, Kansas (Address)

SUBSCRIBED AND SWORN TO before me this 18th day of September, 19 53

Verdella M. Hankins  
Notary Public.  
My commission expires December 4, 1954

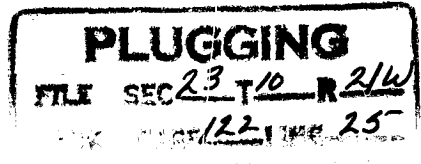

DRILLER'S LOG

Company: Anderson-Prichard Oil Corporation

Section 23 Township 10S, Range 21W  
NW SW NE

Farm: Pierce Well No. 1

County: Graham,  
Kansas

Total Depth: 3760' (Rotary)

Comm.: 8-19-49 Comp. 8-30-49  
Contractor: Glenn Peel Drilling Co., Inc.

Elevation:

Casing:  
8 5/8" 277' cem.  
5 1/2" 3755 1/2' cem.

Production:

Figures below indicate bottom of formations

Surface Rock & Clay	0 -	100
Shale & Shells		160
Sand & Shale		190
Shale & Shells		250
Shale		278
Shale & Shells		785
Sand		815
Sand & Shale		1395
Shells		1475
Shale & Shells		1652
Anhydrite		1692
Shale		1715
Shale & Lime Streaks		1950
Shale & Shells		2195
Lime & Broken Streaks		2330
Shale		2378
Lime		2645
Lime & Shale		2760
Lime & Shale Streaks		2890
Lime & Shale		3000
Shale & Lime		3270
Lime		3760
Total Depth (Rotary)		3760

This is to certify that the above information is, to the best of our knowledge, true and correct.

STATE OF KANSAS

GLENN PEEL DRILLING COMPANY, INC.

CONSERVATION

BY: J. B. Anderson

SUBSCRIBED AND SWORN to before me this 31st day of August, 1949

My commission expires June 4, 1951

Marian M. Nestor  
Notary Public

**PLUGGING**  
WELL SEC 23 T 10 R 21W  
BOOK PAGE 122 LINE 25