


WELL PLUGGING RECORD

Give All Information Completely
Make Required Affidavit
Mail or Deliver Report to:
Conservation Division
State Corporation Commission
800 Bitting Building
Wichita, Kansas

Graham County, Sec. 23 Twp. 10 Rge. 21 W(E) (W)
Location as "NE/CNW $\frac{1}{4}$ SW $\frac{1}{4}$ " or footage from lines NE NE NE
Lease Owner The Derby Oil Company
Lease Name Pierce Well No. 3
Office Address 422 West Douglas, Wichita, Kansas
Character of Well (completed as Oil, Gas or Dry Hole) Oil Well
Date well completed 5 - 6 - 19 51
Application for plugging filed 3 - 12 - 19 52
Application for plugging approved 3 - 12 - 19 52
Plugging commenced 4 - 10 - 19 52
Plugging completed 4 - 16 - 19 52
Reason for abandonment of well or producing formation Depletion of Arbuckle.

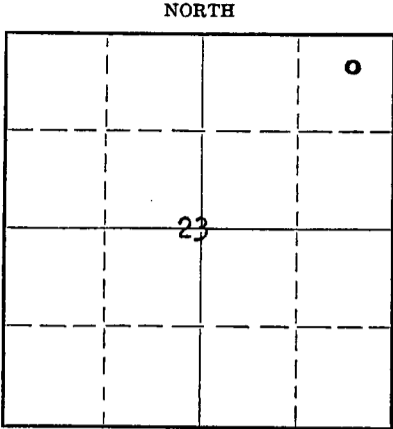

Locate well correctly on above Section Plat

If a producing well is abandoned, date of last production 19...
Was permission obtained from the Conservation Division or its agents before plugging was commenced? Yes

Name of Conservation Agent who supervised plugging of this well Eldon Petty
Producing formation Arbuckle Depth to top 3744 Bottom Total Depth of Well 3761 Feet
Show depth and thickness of all water, oil and gas formations.

OIL, GAS OR WATER RECORDS

CASING RECORD

Formation	Content	From	To	Size	Put In	Pulled Out
Arbuckle	Oil			4 1/2"	3745'	3118'

Describe in detail the manner in which the well was plugged, indicating where the mud fluid was placed and the method or methods used in introducing it into the hole. If cement or other plugs were used, state the character of same and depth placed, from feet to feet for each plug set.

Filled hole with chat to 3735'. Shot pipe off at 3118'. Pulled pipe and put 4 sacks of cement at bottom. Finished mudding hole to 250'. Set rock bridge and dumped 15 sacks of cement at 250'. Mudded hole to top and put 10 sacks of cement at surface.

RECEIVED
STATE CORPORATION COMMISSION
MAY - 2 1952
CONSERVATION DIVISION
WICHITA, KANSAS
05-02-52

Name of Plugging Contractor Bert Self
Address Hutchinson, Kansas

STATE OF Kansas, COUNTY OF Sedgwick, ss.
E. W. Heiser (employee of owner) or (owner or operator) of the above-described well, being first duly sworn on oath, says: That I have knowledge of the facts, statements, and matters herein contained and the log of the above-described well as filed and that the same are true and correct. So help me God.

(Signature) *E. W. Heiser*

The Derby Oil Company
(Address)

SUBSCRIBED AND SWORN to before me this 30th day of April, 19 52

H. A. Bilson
H. A. Bilson, Notary Public.

My commission expires August 24, 1953

PLUGGING
FILE SEC 23 T 10 R 214
BOOK PAGE 149 LINE 4V

DRILLER'S LOG

Company: Derby Oil Company

Farm: Pierce Well No. 3

Total Depth: 3748'

Comm: 5-13-51 Comp: 5-21-51

Contractor: Glenn W. Peel

Casing:

8 5/8" 250' con.
4 1/2" 3745' con.

NE NE NE

Sec. 23 Twp. 10S Rge. 21W

County: Graham,
Kansas

Elevation:

Production:

Figures below indicate bottom of formations

Clay & Rock	0 -	40
Rock & Shells		250
Shale & Shells		1110
Sand & Shale		1385
Shale, Red Bed & Shells		1635
Anhydrite		1680
Shale, Red Bed & Shells		2050
Shale & Shells		2320
Line & Shale		2460
Line		2680
Line & Shale		2850
Line		2975
Shale w/line streaks		3225
Line		3300
Line & Shale		3560
Line		3645
Line & Shale		3700
Line		3748
Total Depth		3748

This is to certify that the above information is, to the best of our knowledge, true and correct.

GLENN W. PEEL

BY: *Glenn W. Peel*

SUBSCRIBED AND SWORN to before me this 23rd day of May, 1951.

My commission expires June 14, 1951 *Marion M. Heald*
Notary Public

RECEIVED
STATE GEOLOGICAL SURVEY
MAY 22 1951
CONSERVATION DIVISION
Wichita, Kansas

PLUGGING
FILE SEC-23 T-10 R-214
BOOK PAGE 149 LINE 42